

CORRECTION TO WATER WELL RECORD (WWC-5)

The following correction(s) was made to the attached WWC-5 log, in order to file the item or to rectify lacking or incorrect information.

Fraction (1/4 1/4 1/4) Section-Township-Range changed:

listed as NW NW SE, 34-265-17W

changed to NW NW SE, 34-265-15W

Other changes: Initial statements: _____

Changed to: _____

Comments: _____


verification method: written & legal descriptions, position on plat map,
and Hopewell & Cullison 1:24,000 topo. maps. initials: DR date: 5/9/2001

submitted by: Kansas Geological Survey, Data Resources Library, 1930 Constant Ave., Lawrence, KS 66047-3726
to: Kansas Dept of Health & Environment Bureau of Water Industrial Programs, Bldg 283, Forbes Field, KS 66620

1 LOCATION OF WATER WELL: County: **Pratt** Fraction: **NW 1/4 SE 1/4** Section Number: **34** Township Number: **T 26 S** Range Number: **R 17 EW**

Distance and direction from nearest town or city street address of well if located within city?
4 1/2 S 27 E Hopewell Kansas

2 WATER WELL OWNER: **Right Game Commission**
 RR#, St. Address, Box #: **Pratt Kans**
 City, State, ZIP Code: **Pratt Kans**
 Board of Agriculture, Division of Water Resources
 Application Number:

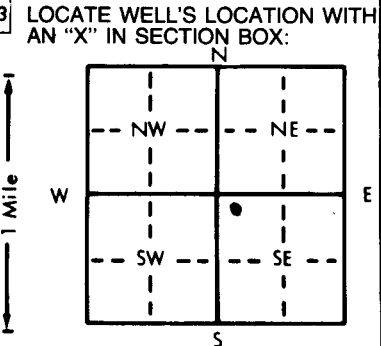

4 DEPTH OF COMPLETED WELL: **80** ft. ELEVATION: _____
 Depth(s) Groundwater Encountered 1. **47** ft. 2. _____ ft. 3. _____ ft.
 WELL'S STATIC WATER LEVEL: **47** ft. below land surface measured on **4-20-81**
 Pump test data: Well water was **47** ft. after _____ hours pumping _____ gpm
 Est. Yield **25** gpm. Well water was _____ ft. after _____ hours pumping _____ gpm
 Bore Hole Diameter: **8 3/4** in. to **80** in. to _____ in. to _____ in. to _____ ft.
 WELL WATER TO BE USED AS:
 1 Domestic 3 Feedlot 6 Oil field water supply 9 Dewatering 12 Other (Specify below)
 2 Irrigation 4 Industrial 7 Lawn and garden only 10 Observation well
 Was a chemical/bacteriological sample submitted to Department? Yes _____ No X; If yes, mo/day/yr sample was submitted _____
 Water Well Disinfected? Yes X No _____

5 TYPE OF BLANK CASING USED:
 1 Steel 3 RMP (SR) 5 Wrought iron 8 Concrete tile CASING JOINTS: Glued X Clamped _____
 2 PVC 4 ABS 6 Asbestos-Cement 9 Other (specify below) Welded _____
 7 Fiberglass Threaded _____
 Blank casing diameter: **5** in. to **60** ft., Dia _____ in. to _____ ft., Dia _____ in. to _____ ft.
 Casing height above land surface: **12** in., weight **13** lbs./ft. Wall thickness or gauge No. **SDR-26**
 TYPE OF SCREEN OR PERFORATION MATERIAL:
 1 Steel 3 Stainless steel 5 Fiberglass 8 RMP (SR) 10 Asbestos-cement 11 Other (specify) _____
 2 Brass 4 Galvanized steel 6 Concrete tile 9 ABS 12 None used (open hole)
 SCREEN OR PERFORATION OPENINGS ARE:
 1 Continuous slot 3 Mill slot 5 Gauzed wrapped 8 Saw cut 11 None (open hole)
 2 Louvered shutter 4 Key punched 6 Wire wrapped 9 Drilled holes
 7 Torch cut 10 Other (specify) _____
 SCREEN-PERFORATED INTERVALS: From **60** ft. to **80** ft., From _____ ft. to _____ ft.
 From _____ ft. to _____ ft., From _____ ft. to _____ ft.
 GRAVEL PACK INTERVALS: From **45** ft. to **80** ft., From _____ ft. to _____ ft.
 From _____ ft. to _____ ft., From _____ ft. to _____ ft.

6 GROUT MATERIAL: 1 Neat cement 2 Cement grout 3 Bentonite 4 Other _____
 Grout Intervals: From **0** ft. to **10** ft., From _____ ft. to _____ ft., From _____ ft. to _____ ft.
 What is the nearest source of possible contamination:
 1 Septic tank 4 Lateral lines 7 Pit privy 10 Livestock pens 14 Abandoned water well
 2 Sewer lines 5 Cess pool 8 Sewage lagoon 11 Fuel storage 15 Oil well/Gas well
 3 Watertight sewer lines 6 Seepage pit 9 Feedyard 12 Fertilizer storage 16 Other (specify below) **PASTURE**
 13 Insecticide storage
 Direction from well? _____
 How many feet? _____

FROM	TO	LITHOLOGIC LOG	FROM	TO	LITHOLOGIC LOG
0	1	Top Soil			
1	5	Silt + Sand			
5	23	lt. BR. Clay			
23	33	Clay with Gravel streaks			
33	45	lt. BR. Clay			
45	63	Gravel			
63	71	BR. Clay			
71	73	Gravel			
73	80	BR. Clay			

7 CONTRACTOR'S OR LANDOWNER'S CERTIFICATION: This water well was (1) constructed, (2) reconstructed, or (3) plugged under my jurisdiction and was completed on (mo/day/year) **4-20-81** and this record is true to the best of my knowledge and belief in **Pratt, Kansas**
 Water Well Contractor's License No. **224** This Water Well Record was completed on (mo/day/yr) **7-5-81** by (signature) **Carl Hayse**
 under the business name of **Carl Hayse Water Well Serv.** by (signature) **Carl Hayse**

INSTRUCTIONS: Use typewriter or ball point pen, PLEASE PRESS FIRMLY and PRINT clearly. Please fill in blanks, underline or circle the correct answers. Send top three copies to Kansas Department of Health and Environment, Division of Environment, Environmental Geology Section, Topeka, KS 66620. Send one to WATER WELL OWNER and retain one for your records.