


WATER WELL RECORD Form WWC-5 KSA 82a-1212

1 LOCATION OF WATER WELL: Fraction Section Number Township Number Range Number
 COUNTY: 024 EDWARDS NE 1/4 SE 1/4 NW 1/4 15 T 26 S R 16 W

Distance and direction from nearest town or city street address of well if located within city?
 1 1/2 E. 2 S. OF TROUSDALE, KS

2 WATER WELL OWNER: NORMAN WOOD 342 Board of Agriculture, Division of Water Resources
 RR#, St. Address, Box #: R.R. Application Number:
 City, State, ZIP code: HAVILAND, KS 67059-

3 LOCATE WELL'S LOCATION WITH AN "X" IN SECTION BOX:

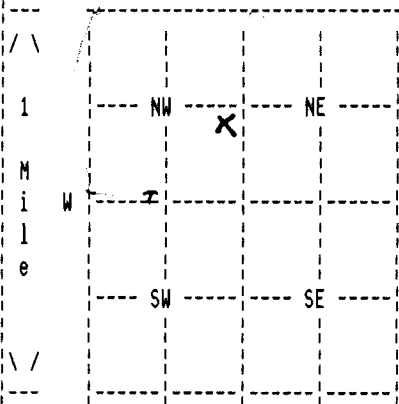

4 DEPTH OF COMPLETED WELL 24 ELEVATION: 0
 Depth(s) Groundwater Encountered 1. 21 ft. 2. 0 ft. 3. 0 ft.

WELL'S STATIC WATER LEVEL 21 ft. below land surface measured on mo/day/yr
 Pump testdata: Well water was 0 ft. after 0 hours pumping 0 gpm

Estimated Yield 0 gpm: Well water was 0 ft. after 0 hours pumping 0 gpm

Bore Hole Diameter 1.25 in. to 24 ft., and in. to 0 ft.

WELL WATER TO BE USED AS: 01 DOMESTIC

Was a chemical/bacteriological sample submitted to department? No;
 If yes, mo/day/yr sample was submitted Water well disinfected? No

5 TYPE OF BLANK CASING USED: 01 STEEL CASING JOINTS: THREADED
 Blank casing diameter 1.25 in. to 21 ft., Dia in. to 0 ft., Dia in. to 0 ft.
 Casing height above land surface -72 in., weight 0 lbs/ft. Wall thickness or gauge No.
 TYPE OF SCREEN OR PERFORATION MATERIAL: 01 STEEL
 SCREEN OR PERFORATION OPENINGS ARE: 05 GAUZE WRAP.

SCREEN PERFORATED INTERVALS: From 21 ft. to 24 ft., From 0 ft. to 0 ft.
 From 0 ft. to 0 ft., From 0 ft. to 0 ft.
 GRAVEL PACK INTERVALS: From 0 ft. to 0 ft., From 0 ft. to 0 ft.
 From 0 ft. to 0 ft., From 0 ft. to 0 ft.

6 GROUT MATERIAL 04 OTHER
 Grout Intervals: From 0 ft. to 0 ft., From 0 ft. to 0 ft., From 0 ft. to 0 ft.
 What is the nearest source of possible contamination: CATTLE PASTURE
 Direction from well? ALL How many feet? 6

FROM	TO	LITHOLOGIC LOG	FROM	TO	PLUGGING INTERVALS
			24	6	HOLE PLUG
			6	0	FILL WITH SOIL
			0	0	
			0	0	
			0	0	
			0	0	
			0	0	
			0	0	
			0	0	

7 CONTRACTOR'S OR LANDOWNER'S CERTIFICATION: This water well was Plugged under my jurisdiction and was completed on (mo/day/year) 11-06-95 and this record is true to the best of my knowledge and belief. Kansas Water Well Contractor's License No. 224 This Water Well Record was completed on (mo/day/yr) 11/30/95 under the business name of CARL HAYSE WATER WELL SVC by (signature) Carl Hayse