


1 LOCATION OF WATER WELL: Fraction  $\frac{1}{4}$  C S  $\frac{1}{2}$  NW  $\frac{1}{4}$  Section Number 1 Township Number T 26 S Range Number R 16 E (W)

Distance and direction from nearest town or city street address of well if located within city?  
 $\frac{1}{2}$  N 3E  $\frac{3}{8}$  S  $\frac{1}{4}$  E OF TROUSDALE, KS

2 WATER WELL OWNER: Robert Gay, Energy Enterprises  
 RR#, St. Address, Box #: 1006 N. Main Board of Agriculture, Division of Water Resources  
 City, State, ZIP Code: Hutchinson, Kansas 67505 Lease: Fousst # 1-G5 Application Number:

3 LOCATE WELL'S LOCATION WITH AN "X" IN SECTION BOX:

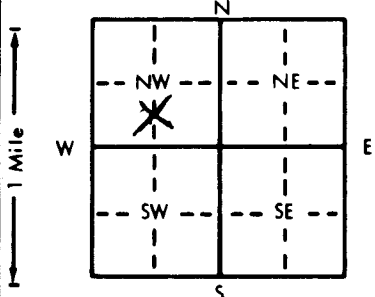

4 DEPTH OF COMPLETED WELL: 80 ft. ELEVATION:

Depth(s) Groundwater Encountered 1. 20 ft. 2. ft. 3. ft.  
 WELL'S STATIC WATER LEVEL . . . ft. below land surface measured on mo/day/yr  
 Pump test data: Well water was . . . ft. after . . . hours pumping . . . gpm  
 Est. Yield 100 gpm: Well water was . . . ft. after . . . hours pumping . . . gpm  
 Bore Hole Diameter . 10 in. to 80 ft., and . . . in. to . . . ft.  
 WELL WATER TO BE USED AS:  
 1 Domestic 3 Feedlot 6 Oil field water supply 9 Dewatering 12 Other (Specify below)  
 2 Irrigation 4 Industrial 7 Lawn and garden only 10 Observation well  
 Was a chemical/bacteriological sample submitted to Department? Yes . . . No . . . X . . . ; If yes, mo/day/yr sample was submitted  
 Water Well Disinfected? Yes X No

5 TYPE OF BLANK CASING USED:  
 1 Steel 3 RMP (SR) 5 Wrought iron 8 Concrete tile CASING JOINTS: Glued X Clamped . . .  
 2 PVC 4 ABS 6 Asbestos-Cement 9 Other (specify below) Welded . . .  
 7 Fiberglass . . . Threaded . . .

Blank casing diameter 5 in. to 60 ft., Dia . . . in. to . . . ft., Dia . . . in. to . . . ft.  
 Casing height above land surface 12 in., weight . . . lbs./ft. Wall thickness or gauge No. 214

TYPE OF SCREEN OR PERFORATION MATERIAL:  
 1 Steel 3 Stainless steel 5 Fiberglass 8 RMP (SR) 10 Asbestos-cement  
 2 Brass 4 Galvanized steel 6 Concrete tile 9 ABS 12 None used (open hole)

SCREEN OR PERFORATION OPENINGS ARE:  
 1 Continuous slot 3 Mill slot 5 Gauzed wrapped 8 Saw cut 11 None (open hole)  
 2 Louvered shutter 4 Key punched 6 Wire wrapped 9 Drilled holes  
 7 Torch cut 10 Other (specify)

SCREEN-PERFORATED INTERVALS: From 60 ft. to 80 ft., From . . . ft. to . . . ft.  
 GRAVEL PACK INTERVALS: From 10 ft. to 80 ft., From . . . ft. to . . . ft.

6 GROUT MATERIAL: 1 Neat cement 2 Cement grout 3 Bentonite 4 Other . . .  
 Grout Intervals: From 0 ft. to 10 ft., From . . . ft. to . . . ft., From . . . ft. to . . . ft.

What is the nearest source of possible contamination:  
 1 Septic tank 4 Lateral lines 7 Pit privy 10 Livestock pens 14 Abandoned water well  
 2 Sewer lines 5 Cess pool 8 Sewage lagoon 11 Fuel storage 15 Oil well/Gas well  
 3 Watertight sewer lines 6 Seepage pit 9 Feedyard 12 Fertilizer storage 16 Other (specify below)  
 13 Insecticide storage NONE

Direction from well? How many feet?

FROM	TO	LITHOLOGIC LOG	FROM	TO	LITHOLOGIC LOG
0	2	Soil, sandy			
2	10	Sand, fine			
10	20	Clay, gray			
20	40	Sand, very fine			
40	60	Sand, fine to coarse with clay, dirty			
60	80	Sand, fine to coarse and fine to coarse gravel			

7 CONTRACTOR'S OR LANDOWNER'S CERTIFICATION: This water well was (1) constructed, (2) reconstructed, or (3) plugged under my jurisdiction and was completed on (mo/day/year) 26 DEC 83 and this record is true to the best of my knowledge and belief. Kansas Water Well Contractor's License No. 325 This Water Well Record was completed on (mo/day/yr) 27 FEB 84 under the business name of Central Well & Pump Inc. by (signature) J. J. Honanich

INSTRUCTIONS: Use typewriter or ball point pen, PLEASE PRESS FIRMLY and PRINT clearly. Please fill in blanks, underline or circle the correct answers. Send top three copies to Kansas Department of Health and Environment, Division of Environment, Environmental Geology Section, Topeka, KS 66620. Send one to WATER WELL OWNER and retain one for your records.

OFFICE USE ONLY  
T  
R  
EW  
SEC.