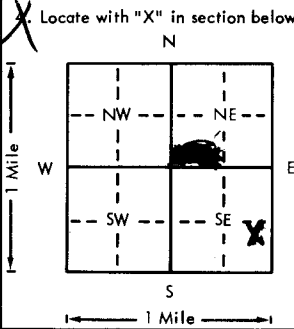


USE TYPEWRITER OR BALL POINT PEN-PRESS FIRMLY, PRINT CLEARLY.

WATER WELL RECORD
KSA 82a-1201-1215

Kansas Department of Health and Environment-Division of Environment (Water well Contractors) Topeka, Kansas 66620

1. Location of well: County <u>EDWARDS</u> Fraction <u>SE</u> Section number <u>4</u> Township number <u>T 26</u> Range number <u>R 16</u> EM	
2. Distance and direction from nearest town or city: <u>TROUSDALE</u> <u>1 1/2 EAST 1/4 SOUTH</u> Street address of well location if in city:	
3. Owner of well: <u>STERLING DRIG</u> R.R. or street: <u>Box 129</u> City, state, zip code: <u>STERLING, Ks. 67519</u>	
4. Locate with "X" in section below: Sketch map: 	
5. Type and color of material	
	From To
	<u>Five Sand</u> 0 10
	<u>Clay</u> 10 20
	<u>SANDY CLAY</u> 20 45
	<u>GRAVEL</u> 45 70
6. Bore hole dia. <u>9</u> in. Completion date <u>2-22-79</u> Well depth <u>70</u> ft.	
7. Cable tool <input checked="" type="checkbox"/> Rotary <input type="checkbox"/> Driven <input type="checkbox"/> Dug <input type="checkbox"/> Hollow rod <input type="checkbox"/> Jetted <input type="checkbox"/> Bored <input type="checkbox"/> Reverse rotary	
8. Use: <input type="checkbox"/> Domestic <input type="checkbox"/> Public supply <input type="checkbox"/> Industry <input type="checkbox"/> Irrigation <input type="checkbox"/> Air conditioning <input type="checkbox"/> Stock <input type="checkbox"/> Lawn <input checked="" type="checkbox"/> Oil field water <input type="checkbox"/> Other	
9. Casing: Material <input type="checkbox"/> Height: Above or below Threaded <input type="checkbox"/> Welded <input checked="" type="checkbox"/> Surface <u>12</u> in. RMP <input type="checkbox"/> PVC <input checked="" type="checkbox"/> Weight <u>278.3</u> lbs./ft. Dia. <u>5</u> in. to <u>70</u> ft. depth Wall Thickness: inches or Dia. <u>5</u> in. to <u>70</u> ft. depth gage No. <u>266</u>	
10. Screen: Manufacturer's name <u>Pitless</u> Type <u>Saw</u> Dia. <u>5</u> Slot/gauze <u>1/8</u> Length <u>20</u> Set between <u>70</u> ft. and <u>150</u> ft. ft. and <u>150</u> ft. Gravel pack? <input checked="" type="checkbox"/> Size range of material <u>1/4-1/8</u>	
11. Static water level: <u>36</u> ft. below land surface Date <u>2-22-79</u> mo./day/yr.	
12. Pumping level below land surfaces: <u>10</u> ft. after <u>0</u> hrs. pumping <u>0</u> g.p.m. ft. after <u>0</u> hrs. pumping <u>0</u> g.p.m. Estimated maximum yield <u>0</u> g.p.m.	
13. Water sample submitted: <u>0</u> mo./day/yr. <input type="checkbox"/> Yes <input checked="" type="checkbox"/> No Date	
14. Well head completion: <u>12</u> Inches above grade <input type="checkbox"/> Pitless adapter	
15. Well grouted? <input checked="" type="checkbox"/> <u>yes</u> With: <input type="checkbox"/> Neat cement <input checked="" type="checkbox"/> Bentonite <input type="checkbox"/> Concrete Depth: From <u>0</u> ft. to <u>10</u> ft.	
16. Nearest source of possible contamination: <u>None</u> ft. Direction Type Well disinfected upon completion? <input type="checkbox"/> Yes <input checked="" type="checkbox"/> No	
17. Pump: <input checked="" type="checkbox"/> Not installed Manufacturer's name Model number HP Volts Length of drop pipe ft. capacity g.p.m. Type: <input type="checkbox"/> Submersible <input type="checkbox"/> Turbine <input type="checkbox"/> Jet <input type="checkbox"/> Reciprocating <input type="checkbox"/> Centrifugal <input type="checkbox"/> Other	
(Use a second sheet if needed)	
18. Elevation:	19. Remarks:
Topography: <input type="checkbox"/> Hill <input checked="" type="checkbox"/> Slope <input type="checkbox"/> Upland <input type="checkbox"/> Valley	
20. Water well contractor's certification: This well was drilled under my jurisdiction and this report is true to the best of my knowledge and belief. <u>Myers Water Well</u> <u>143</u> Business name License No. Address <u>GREAT BEND Ks. 67530</u> Signed <u>Raymond Rosendall</u> Date <u>2-22-79</u> Authorized representative	

T 26 R 16 E 4 NE SE SE

Forward the white, blue and pink copies to the Department of Health and Environment

Form WWC-5