


1 LOCATION OF WATER WELL: County: Edwards Fraction: near G₄ of n side s_{1/2} SW_{1/4} Section Number: 4 Township Number: T 26 S Range Number: R 16 E/W

Distance and direction from nearest town or city street address of well if located within city?
1/4 south east of Trousdale

2 WATER WELL OWNER: Mrs. Cleone O. Michael
 RR#, St. Address, Box #: 2601 Heather Parkway Board of Agriculture, Division of Water Resources
 City, State, ZIP Code: Hutchinson, Ks. 67501 Application Number: 34,912

3 LOCATE WELL'S LOCATION WITH AN "X" IN SECTION BOX:

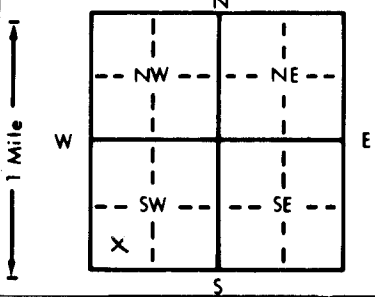

4 DEPTH OF COMPLETED WELL: 155 ft. ELEVATION:

Depth(s) Groundwater Encountered 1. 45 ft. 2. ft. 3. ft.
 WELL'S STATIC WATER LEVEL: 65 ft. below land surface measured on mo/day/yr 3-3-81
 Pump test data: Well water was 50 ft. after 1 hours pumping 1100 gpm
 Est. Yield 1400 gpm: Well water was 56 ft. after 1 1/2 hours pumping 1400 gpm
 Bore Hole Diameter: 29 in. to 155 ft., and in. to ft.
 WELL WATER TO BE USED AS:
 5 Public water supply 8 Air conditioning 11 Injection well
 1 Domestic 3 Feedlot 6 Oil field water supply 9 Dewatering 12 Other (Specify below)
2 Irrigation 4 Industrial 7 Lawn and garden only 10 Observation well
 Was a chemical/bacteriological sample submitted to Department? Yes.....No X.....; If yes, mo/day/yr sample was submitted
 Water Well Disinfected? Yes HTH No

5 TYPE OF BLANK CASING USED:
 1 Steel 3 RMP (SR) 5 Wrought iron 8 Concrete tile CASING JOINTS: Glued Clamped
 2 PVC 4 ABS 6 Asbestos-Cement 9 Other (specify below) Welded X
 7 Fiberglass Threaded.....

Blank casing diameter: 16 in. to 115 ft., Dia in. to ft., Dia in. to ft.
 Casing height above land surface: 18 in., weight lbs./ft. Wall thickness or gauge No. 7

TYPE OF SCREEN OR PERFORATION MATERIAL:
 1 Steel 3 Stainless steel 5 Fiberglass 7 PVC 10 Asbestos-cement
 2 Brass 4 Galvanized steel 6 Concrete tile 8 RMP (SR) 11 Other (specify)
 9 ABS 12 None used (open hole)

SCREEN OR PERFORATION OPENINGS ARE:
 1 Continuous slot 3 Mill slot 5 Gauzed wrapped 8 Saw cut 11 None (open hole)
 2 Louvered shutter 4 Key punched 6 Wire wrapped 9 Drilled holes
 7 Torch cut 10 Other (specify)

SCREEN-PERFORATED INTERVALS: From 115 ft. to 155 ft., From ft. to ft.
 From ft. to ft., From ft. to ft.
 GRAVEL PACK INTERVALS: From 0 ft. to 10 ft., From ft. to ft.
 From ft. to ft., From ft. to ft.

6 GROUT MATERIAL: 1 Neat cement 2 Cement grout 3 Bentonite 4 Other

Grout Intervals: From 0 ft. to 10 ft., From ft. to ft., From ft. to ft.

What is the nearest source of possible contamination:
 1 Septic tank 4 Lateral lines 7 Pit privy 10 Livestock pens 14 Abandoned water well
 2 Sewer lines 5 Cess pool 8 Sewage lagoon 11 Fuel storage 5 Oil well/Gas well
 3 Watertight sewer lines 6 Seepage pit 9 Feedyard 12 Fertilizer storage 16 Other (specify below)
 13 Insecticide storage

Direction from well? Southeast How many feet? 600'

FROM	TO	LITHOLOGIC LOG	FROM	TO	LITHOLOGIC LOG
0	2	Sandy top soil			
2	7	Dark black clay			
7	13	Light brown clay			
13	40	Sand and gravel			
40	45	Clay mixed w/sand and gravel			
45	50	White clay			
50	80	Sand and gravel w/clay			
80	85	Sand and gravel			
85	95	Sand and gravel w/clay			
95	140	Sand and gravel			
140	155	Light brown clay			

7 CONTRACTOR'S OR LANDOWNER'S CERTIFICATION: This water well was (1) constructed, (2) reconstructed, or (3) plugged under my jurisdiction and was completed on (mo/day/year) 7-17-82 and this record is true to the best of my knowledge and belief. Kansas Water Well Contractor's License No. 134 This Water Well Record was completed on (mo/day/yr) 9-10-82 under the business name of Rosencrantz-Bemis Ent. by (signature) Lora Dodson

INSTRUCTIONS: Use typewriter or ball point pen, PLEASE PRESS FIRMLY and PRINT clearly. Please fill in blanks, underline or circle the correct answers. Send top three copies to Kansas Department of Health and Environment, Division of Environment, Environmental Geology Section, Topeka, KS 66620. Send one to WATER WELL OWNER and retain one for your records.

OFFICE USE ONLY
T 26
R 16
SEC 4