

CORRECTION TO WATER WELL RECORD (WWC-5)

The following correction(s) was made to the attached WWC-5 log, in order to file the item or to rectify lacking or incorrect information.

Fraction (1/4 1/4 1/4) Section-Township-Range changed:

listed as 5700' FSL, 1285' FEL, Lot 2, 5-26S-16W
changed to NW, NE, NE, 5-26S-16W

Other changes: Initial statements: _____

Changed to: _____

Comments: _____

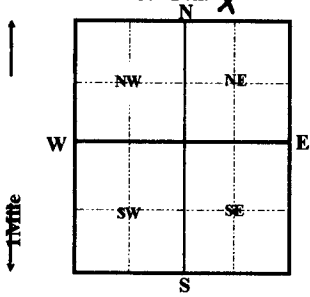
verification method: Written footages, written description on form,
& Trousdale 1:24,000 topo. map. initials: DR date: 2/8/99

submitted by: Kansas Geological Survey, Data Resources Library, 1930 Constant Ave., Lawrence, KS 66047-3726
to: Kansas Dept of Health & Environment Bureau of Water Industrial Programs, Bldg 283, Forbes Field, KS 66620

1 LOCATION OF WATER WELL: Edwards	FRACTION 5700¹FSL 1285¹FEL 1/4 1/4 LOT 2 1/4	Section Number 5	Township Number T 26 S	Range Number R 16W E/W
---	--	----------------------------	----------------------------------	----------------------------------

Distance and direction from nearest town or city street address of well if located within city?
9 m. N., 1 E., 1/4 S., 1/4 W. of Haviland, Kansas

2 WATER WELL OWNER: MAYHEW, Kathryn RR#, ST. ADDRESS, BOX #: CITY, STATE, ZIP CODE: Haviland, Kansas 67059	Board of Agriculture, Division of Water Resource Application Number: 14, 944
--	--

3 LOCATE WELL'S LOCATION WITH AN "X" IN SECTION BOX: 	4 DEPTH OF COMPLETED WELL 110 ft. ELEVATION: 27 Depth(s) groundwater Encountered 1 ft. 2 ft. 3 ft. WELL'S STATIC WATER LEVEL 27 FT. BELOW LAND SURFACE MEASURED ON 03/19/1993 Pump test data: Well water was 36.5 ft. after 1 hours pumping 900 gpm Est. Yield gpm: Well water was 38.5 ft. after 1 hours pumping 1170 gpm Bore Hole Diameter 30 in. to ft., and in. to ft. WELL WATER TO BE USED AS: 1 Domestic 3 Feedlot 6 Oil field water supply 9 Dewatering 11 Injection well 12 Other (Specify below) 2 Irrigation 4 Industrial 7 Lawn and garden only 10 Monitoring well Was a chemical/bacteriological sample submitted to Department? Yes No <input checked="" type="checkbox"/> ; If yes, mo/day/yr sample was submitted Water Well Disinfected? Yes <input checked="" type="checkbox"/> No
--	---

5 TYPE OF CASING USED: 1 Steel 3 RMP (SR) 2 PVC 4 ABS	5 Wrought iron 8 Concrete tile 6 Asbestos-Cement 9 Other (Specify below) 7 Fiberglass	CASING JOINTS: Glued Clamped Welded <input checked="" type="checkbox"/> Threaded
Blank casing Diameter 16 in. to 56 ft., Dia in. to ft., Dia in. to ft.	Casing height above land surface 12 in., weight 42.0 5 lbs. / ft.	Wall thickness or gauge No. .250
TYPE OF SCREEN OR PERFORATION MATERIAL: 1 Steel 3 Stainless Steel 5 Fiberglass 8 RMP (SR) 10 Asbestos-cement 11 other (specify) 2 Brass 4 Galvanized steel 6 Concrete tile 9 ABS 12 None used (open hole)		
SCREEN OR PERFORATION OPENING ARE: 1 Continuous slot 3 Mill slot 5 Gauzed wrapped 8 Saw cut 11 None (open hole) 2 Louvered shutter 4 Key punched 6 Wire wrapped 9 Drilled holes 7 Torch cut 10 Other (specify)		
SCREEN-PERFORATION INTERVALS: from 56 ft. to 110 ft., From ft. to ft. GRAVEL PACK INTERVALS: from 20 ft. to 110 ft., From ft. to ft.		

6 GROUT MATERIAL: 1 Neat cement Grout Intervals: From 0 ft. to 20 ft., From ft. to ft.	2 Cement grout 3 Bentonite 4 Other Bentonite Hole Plug	10 Livestock pens 14 Abandon water well 11 Fuel storage 15 Oil well/Gas well 12 Fertilizer storage 16 Other (specify below) 13 Insecticide storage None Apparent
What is the nearest source of possible contamination: 1 Septic tank 4 Lateral lines 7 Pit privy 2 Sewer lines 5 Cess pool 8 Sewage lagoon 3 Watertight sewer lines 6 Seepage pit 9 Feedyard		

Direction from well?		How many feet?			
FROM	TO	LITHOLOGIC LOG	FROM	TO	PLUGGING INTERVALS
0	2	sandy soil			
2	6	fine sand and silt			
6	18	fine to coarse sand & fine to coarse gravel			
18	31	tan and white clay			
31	50	fine to coarse sand and fine to medium gravel			
50	110	fine to coarse sand and fine to coarse gravel (loose)			
110	112	tan and white clay			

7 CONTRACTOR'S OR LANDOWNER'S CERTIFICATION: This water well was (1) constructed, (2) reconstructed, or (3) plugged under my jurisdiction and was completed on (mo/day/year) 03/19/1993 and this record is true to the best of my knowledge and belief. Kansas Water Well Contractor's License No. 236 This Water Well Record was completed on (mo/day/yr) 03/26/93 Under the business name of Harp Well & Pump Service, Inc by (signature) <i>Jane Frederick</i>	308
--	-----