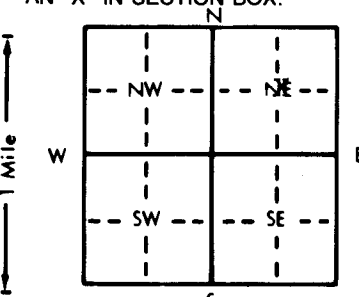


1 LOCATION OF WATER WELL: Fraction NEAR CENTER OF Section Number Township Number Range Number
 County: Edwards 1/4 1/4 NE 1/4 7 T 26 S R 16 E/W

Distance and direction from nearest town or city street address of well if located within city?
 Approx. 9 3/4 miles south and 1 mile west of Belpre, KS

2 WATER WELL OWNER: Roger Parker
 RR#, St. Address, Box #: Trousdale Route Board of Agriculture, Division of Water Resources
 City, State, ZIP Code: Haviland, KS 67059 Application Number: not available

3 LOCATE WELL'S LOCATION WITH AN "X" IN SECTION BOX:

 4 DEPTH OF COMPLETED WELL: 150 ft. ELEVATION: unknown
 Depth(s) Groundwater Encountered 1. 38 ft. 2. ft. 3. ft.
 WELL'S STATIC WATER LEVEL: 38 ft. below land surface measured on mo/day/yr 11-30-82
 Pump test data: Well water was not ok'd ft. after hours pumping gpm
 Est. Yield: 1000 gpm: Well water was ft. after hours pumping gpm
 Bore Hole Diameter 24 in. to 150 ft. and in. to ft.
 WELL WATER TO BE USED AS:
 1 Domestic 3 Feedlot 5 Public water supply 8 Air conditioning 11 Injection well
 2 Irrigation 4 Industrial 6 Oil field water supply 9 Dewatering 12 Other (Specify below)
 7 Lawn and garden only 10 Observation well
 Was a chemical/bacteriological sample submitted to Department? Yes No X; If yes, mo/day/yr sample was submitted Water Well Disinfected? Yes No X

5 TYPE OF BLANK CASING USED:
 1 Steel 3 RMP (SR) 5 Wrought iron 8 Concrete tile CASING JOINTS: Glued Clamped
 2 PVC 4 ABS 6 Asbestos-Cement 9 Other (specify below) Welded XX
 7 Fiberglass Threaded
 Blank casing diameter .16 in. to .90 ft., Dia. in. to ft.
 Casing height above land surface .12 in., weight 42.05 lbs./ft. Wall thickness or gauge No. .250
 TYPE OF SCREEN OR PERFORATION MATERIAL:
 1 Steel 3 Stainless steel 5 Fiberglass 7 PVC 10 Asbestos-cement
 2 Brass 4 Galvanized steel 6 Concrete tile 8 RMP (SR) 11 Other (specify)
 9 ABS 12 None used (open hole)
 SCREEN OR PERFORATION OPENINGS ARE:
 1 Continuous slot 3 Mill slot 5 Gauzed wrapped 8 Saw cut 11 None (open hole)
 2 Louvered shutter 4 Key punched 6 Wire wrapped 9 Drilled holes
 7 Torch cut 10 Other (specify) Doerr Bridge Slot
 SCREEN-PERFORATED INTERVALS: From .90 ft. to 150 ft., From ft. to ft.
 GRAVEL PACK INTERVALS: From .10 ft. to 150 ft., From ft. to ft.

6 GROUT MATERIAL: 1 Neat cement 2 Cement grout 3 Bentonite 4 Other
 Grout Intervals: From 0 ft. to 10 ft., From ft. to ft., From ft. to ft.
 What is the nearest source of possible contamination:
 1 Septic tank 4 Lateral lines 7 Pit privy 10 Livestock pens 14 Abandoned water well
 2 Sewer lines 5 Cess pool 8 Sewage lagoon 11 Fuel storage 15 Oil well/Gas well
 3 Watertight sewer lines 6 Seepage pit 9 Feedyard 12 Fertilizer storage 16 Other (specify below)
 13 Insecticide storage FIELD
 Direction from well? all around well How many feet?

FROM	TO	LITHOLOGIC LOG	FROM	TO	LITHOLOGIC LOG
0	15	Fine sand topsoil & sandy brown clay			
15	89	Sand & gravel, med. clean w/a few thin clay streaks between 15'-49' 80'-89'			
89	95	White & tan sandy clay w/streak of cemented sand			
95	110	Sand & gravel, fine to med., clean			
110	121	Sand & gravel, med. to coarse			
121	131	White & tan clay			
131	148	Sand & gravel, med. to coarse, clean			
148	150	Hard Yellow & tan clay			

7 CONTRACTOR'S OR LANDOWNER'S CERTIFICATION: This water well was (1) constructed, (2) reconstructed, or (3) plugged under my jurisdiction and was completed on (mo/day/year) 11-30-82 and this record is true to the best of my knowledge and belief. Kansas Water Well Contractor's License No. 185 This Water Well Record was completed on (mo/day/yr) 12-7-82 under the business name of Clarke Well & Eq., Inc. by signature [Signature]

INSTRUCTIONS: Use typewriter or ball point pen, PLEASE PRESS FIRMLY and PRINT clearly. Please fill in blanks, underline or circle the correct answers. Send top three copies to Kansas Department of Health and Environment, Division of Environment, Environmental Geology Section, Topeka, KS 66620. Send one to WATER WELL OWNER and retain one for your records.

OFFICE USE ONLY T 26 R 16 E/W SEC. 7 1/4 NE 1/4