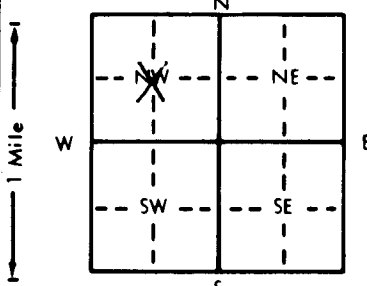


1 LOCATION OF WATER WELL: Fraction  $\frac{1}{4}$  C  $\frac{1}{4}$  NW  $\frac{1}{4}$  Section Number 9 Township Number T 26 S Range Number R 16 EW  
 County: Edwards

Distance and direction from nearest town or city street address of well if located within city?  
 3/4 south of Trousdale

2 WATER WELL OWNER: Mrs. Cleone O. Michael  
 RR#, St. Address, Box # : 2601 Heather Parkway Board of Agriculture, Division of Water Resources  
 City, State, ZIP Code : Hutchinson, Ks. 67501 Application Number: 34,926

3 LOCATE WELL'S LOCATION WITH AN "X" IN SECTION BOX:  


4 DEPTH OF COMPLETED WELL: 150 ft. ELEVATION:  
 Depth(s) Groundwater Encountered 1. 27 ft. 2. ft. 3. ft.  
 WELL'S STATIC WATER LEVEL: 27 ft. below land surface measured on mo/day/yr 3-5-81  
 Pump test data: Well water was 40 ft. after 1 hours pumping 1200 gpm  
 Est. Yield 1400 gpm: Well water was 44 ft. after 1 1/2 hours pumping 1400 gpm  
 Bore Hole Diameter: 29 in. to 150 ft., and in. to ft.  
 WELL WATER TO BE USED AS:  
 5 Public water supply 8 Air conditioning 11 Injection well  
 1 Domestic 3 Feedlot 6 Oil field water supply 9 Dewatering 12 Other (Specify below)  
 0 Irrigation 4 Industrial 7 Lawn and garden only 10 Observation well  
 Was a chemical/bacteriological sample submitted to Department? Yes No  If yes, mo/day/yr sample was submitted  
 Water Well Disinfected? Yes HTH No

5 TYPE OF BLANK CASING USED:  
 Steel 3 RMP (SR) 6 Asbestos-Cement 9 Other (specify below) Welded   
 2 PVC 4 ABS 7 Fiberglass Threaded  
 Blank casing diameter: 29 in. to 90 ft., Dia. in. to ft., Dia. in. to ft.  
 Casing height above land surface: 18 in., weight lbs./ft. Wall thickness or gauge No. 7  
 TYPE OF SCREEN OR PERFORATION MATERIAL:  
 Steel 3 Stainless steel 5 Fiberglass 8 RMP (SR) 10 Asbestos-cement  
 2 Brass 4 Galvanized steel 6 Concrete tile 9 ABS 11 Other (specify)  
 12 None used (open hole)  
 SCREEN OR PERFORATION OPENINGS ARE:  
 1 Continuous slot 3 Mill slot 5 Gauzed wrapped 8 Saw cut 11 None (open hole)  
 Louvered shutter 4 Key punched 6 Wire wrapped 9 Drilled holes  
 7 Torch cut 10 Other (specify)  
 SCREEN-PERFORATED INTERVALS: From 90 ft. to 150 ft., From ft. to ft.  
 From ft. to ft., From ft. to ft.  
 GRAVEL PACK INTERVALS: From 10 ft. to 200 ft., From ft. to ft.  
 From ft. to ft., From ft. to ft.

6 GROUT MATERIAL:  Neat cement 2 Cement grout 3 Bentonite 4 Other  
 Grout Intervals: From 0 ft. to 10 ft., From ft. to ft., From ft. to ft.  
 What is the nearest source of possible contamination:  
 Septic tank 4 Lateral lines 7 Pit privy 10 Livestock pens 14 Abandoned water well  
 2 Sewer lines 5 Cess pool 8 Sewage lagoon 11 Fuel storage 15 Oil well/Gas well  
 3 Watertight sewer lines 6 Seepage pit 9 Feedyard 12 Fertilizer storage 16 Other (specify below)  
 13 Insecticide storage  
 Direction from well? North East How many feet? 1350'

FROM	TO	LITHOLOGIC LOG	FROM	TO	LITHOLOGIC LOG
0	5	Sandy top soil			
5	17	Sand with clay			
17	35	Sand and gravel			
35	50	Sand and clay			
50	60	Sand and gravel			
60	70	clay			
70	90	Clay mixed w/sand & gravel			
90	110	Sand and gravel			
110	125	Clay with gravel			
125	200	Sand and gravel			

7 CONTRACTOR'S OR LANDOWNER'S CERTIFICATION: This water well was (1) constructed, (2) reconstructed, or (3) plugged under my jurisdiction and was completed on (mo/day/year) 7-16-81 and this record is true to the best of my knowledge and belief. Kansas Water Well Contractor's License No. 134 This Water Well Record was completed on (mo/day/yr) 7-21-81 under the business name of Rosencrantz-Bemis Ent. by (signature) *Lora Dodson*

INSTRUCTIONS: Use typewriter or ball point pen, PLEASE PRESS FIRMLY and PRINT clearly. Please fill in blanks, underline or circle the correct answers. Send top three copies to Kansas Department of Health and Environment, Division of Environment, Environmental Geology Section, Topeka, KS 66620. Send one to WATER WELL OWNER and retain one for your records.

OFFICE USE ONLY  
T 26  
R  
16  
EW  
SEC. 9  
1/4