USE TYPEWRITER OR BALL POINT PEN-PRESS FIRMLY, PRINT CLEARLY.

WATER WELL RECORD
KSA 82a-1201-1215

Kansas Department of Health and Environment-Division of Environment
(Water well Contractors)
Topeka, Kansas 66620

1. Location of well:	County	Fraction	Section number	Township number	Range number
	Edwards	1/4 1/4 cse 1/4 x	14	T 26 S	R 16w E/W

2. Distance and direction from nearest town or city: 2½s 3e
Street address of well location if in city: Trusdale, Ks.

3. Owner of well: Union Drlg Co
R.R. or street: 505 Union Ctr
City, state, zip code: Wichita, Ks. 67202

4. Locate with "X" in section below: Sketch map:

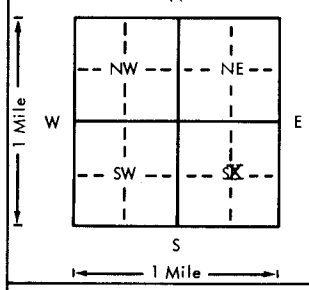

6. Bore hole dia. 8 in. Completion date
Well depth 65 ft. 1-7-78

7. __ Cable tool X Rotary __ Driven __ Dug
__ Hollow rod __ Jetted __ Bored __ Reverse rotary

8. Use: __ Domestic __ Public supply __ Industry
__ Irrigation __ Air conditioning __ Stock
__ Lawn X Oil field water __ Other

9. Casing: Material ____ Height: Above ~~KBDF~~
Threaded ____ Welded ____ Surface 12 in.
RMP ____ PVC X Weight 2.8 lbs./ft.
Dia. 5 in. to 65 ft. depth Wall Thickness: inches or
Dia. ____ in. to ____ ft. depth gage No sch 40

5. Type and color of material	From	To
Top Soil-Clay	0	25
Samd-Gravel	25	65
(Use a second sheet if needed)		

10. Screen: Manufacturer's name
Jetstream
Type pvc Dia. 5"
Slot/gauze 1/32" Length 30
Set between 35 ft. and 65 ft.
____ ft. and ____ ft.
Gravel pack? X Size range of material 1/8-3/4"

11. Static water level: mo./day/yr.
23 ft. below land surface Date 1-7-78

12. Pumping level below land surfaces:
____ ft. after ____ hrs. pumping ____ g.p.m.
____ ft. after ____ hrs. pumping ____ g.p.m.
Estimated maximum yield 50 g.p.m.

13. Water sample submitted: mo./day/yr.
__ Yes X No Date

14. Well head completion:
__ Pitless adapter X Inches above grade

15. Well grouted? X
With: __ Neat cement X Bentonite __ Concrete
Depth: From 0 ft. to 10 ft.

16. Nearest source of possible contamination:
ft. 70 Direction se Type oil test
Well disinfected upon completion? ____ Yes X No

17. Pump: Not installed
Manufacturer's name ##########Gould's
Model number utm HP 3 Volts 230
Length of drop pipe 48 ft. capacity 50 g.p.m.
Type:
X Submersible __ Turbine
__ Jet __ Reciprocating
__ Centrifugal __ Other

18. Elevation:
Topography:
__ Hill
__ Slope
X Upland
__ Valley

19. Remarks:

20. Water well contractor's certification:
This well was drilled under my jurisdiction and this report is true to the best of my knowledge and belief.
Kellys Waterwell Ser 186
Business name License No.
Address R2 Great Bend, Ks.
Signed Kelly Price Date 8-22-79
Authorized representative

T 26 R 16 E Sec 14 1/4 cse 1/4 1/4 1/4

Forward the white, blue and pink copies to the Department of Health and Environment

Form WWC-5

MI-1023