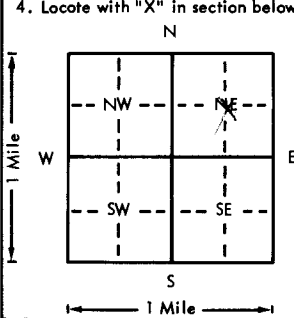


USE TYPEWRITER OR BALL POINT PEN-PRESS FIRMLY, PRINT CLEARLY.

WATER WELL RECORD
KSA 82a-1201-1215

Kansas Department of Health and Environment-Division of Environment
(Water well Contractors)
Topeka, Kansas 66620

1. Location of well:		County Edwards	Fraction 1/4 1/4 1/4	Section number 14	Township number T 26 S R 16 E/W	Range number
2. Distance and direction from nearest town or city: Street address of well location if in city:		1/2 SOUTH - 3245 1/2 SOUTH TROUSDALE		3. Owner of well: Ron Schultz R.R. or street: City, state, zip code: Trousdale, Ks		
4. Locate with "X" in section below: 		Sketch map:		6. Bore hole dia. 2 3/4 in. Completion date 3-6-75 Well depth 99 ft.		
5. Type and color of material		From	To	7. <input type="checkbox"/> Cable tool <input checked="" type="checkbox"/> Rotary <input type="checkbox"/> Driven <input type="checkbox"/> Dug <input type="checkbox"/> Hollow rod <input type="checkbox"/> Jetted <input type="checkbox"/> Bored <input type="checkbox"/> Reverse rotary		
Sandy Top Soil		0	2	8. Use: <input type="checkbox"/> Domestic <input type="checkbox"/> Public supply <input type="checkbox"/> Industry <input checked="" type="checkbox"/> Irrigation <input type="checkbox"/> Air conditioning <input type="checkbox"/> Stack <input type="checkbox"/> Lawn <input type="checkbox"/> Oil field water <input type="checkbox"/> Other		
Sandy Brown Clay		2	4	9. Casing: Material Steel Height: Above or below Threaded <input type="checkbox"/> Welded <input checked="" type="checkbox"/> Surface 18 in. RMP <input type="checkbox"/> PVC <input type="checkbox"/> Weight <input type="checkbox"/> lbs./ft. Dia. 1 1/2 in. to 99 ft. depth Wall Thickness: inches or Dia. <input type="checkbox"/> in. to <input type="checkbox"/> ft. depth gage No. 7		
Gray Clay		4	9	10. Screen: Manufacturer's name Doerrs Type steel Dia. 1 1/2 3/16 Length 40 Set between 59 ft. and 99 ft. ft. and <input type="checkbox"/> ft. Gravel pack? <input checked="" type="checkbox"/> Size range of material 1/2 3/4 1/2		
Brown & Gray Clay		9	16	11. Static water level: <input type="checkbox"/> mo./day/yr. 15 ft. below land surface Date 9-6-74		
Brown Clay		16	32	12. Pumping level below land surfaces: 17 ft. after 1 hrs. pumping 1400 g.p.m. <input type="checkbox"/> ft. after <input type="checkbox"/> hrs. pumping <input type="checkbox"/> g.p.m. Estimated maximum yield 1400 g.p.m.		
Sand & Gravel clean coarse loose		32	64	13. Water sample submitted: <input checked="" type="checkbox"/> Yes <input type="checkbox"/> No Date 9-13-74 mo./day/yr.		
Yellow Brown Clay		64	68	14. Well head completion: <input type="checkbox"/> Pitless adapter <input type="checkbox"/> Inches above grade		
Sand & Gravel clean coarse loose		68	98	15. Well grouted? <input checked="" type="checkbox"/> With: <input type="checkbox"/> Neat cement <input type="checkbox"/> Bentonite <input checked="" type="checkbox"/> Concrete Depth: From 0 ft. to 10 ft.		
Brown		98	102	16. Nearest source of possible contamination: ft. 4M Direction N Type SEPTIC Well disinfected upon completion? <input type="checkbox"/> Yes <input type="checkbox"/> No		
				17. Pump: Not installed Manufacturer's name WELA Model number 4-BHCS12-HP 200 Volts <input type="checkbox"/> Length of drop pipe 70 ft. capacity 1200 g.p.m. Type: <input type="checkbox"/> Submersible <input checked="" type="checkbox"/> Turbine <input type="checkbox"/> Jet <input type="checkbox"/> Reciprocating <input type="checkbox"/> Centrifugal <input type="checkbox"/> Other		
				(Use a second sheet if needed)		
18. Elevation: Topography: <input type="checkbox"/> Hill <input type="checkbox"/> Slope <input checked="" type="checkbox"/> Upland <input type="checkbox"/> Valley		19. Remarks:		20. Water well contractor's certification: This well was drilled under my jurisdiction and this report is true to the best of my knowledge and belief. Rosenkrantz Bernis 134 Business name License No. Address Great Bend, Ks Signed Fredia Dodson Date 9/29/74 Authorized representative		

T 26 S R 16 E
 Sec 14 C NE
 1/4 1/4 1/4

Forward the white, blue and pink copies to the Department of Health and Environment

Form WWC-5