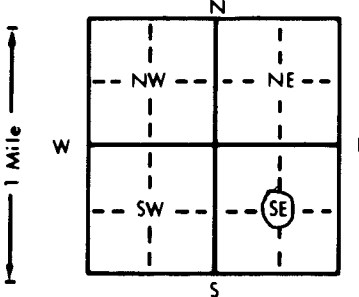


1] LOCATION OF WATER WELL: County: Edwards Fraction: 1/4 1/4 SE 1/4 Section Number: 15 Township Number: T 26 S Range Number: R 16 E/W

Distance and direction from nearest town or city street address of well if located within city?
Approximately 2 Miles South and 3 Miles East of Trousdale

2] WATER WELL OWNER: Mr. Norman E. Wood
 RR#, St. Address, Box #: Route 1 - Box 75 Board of Agriculture, Division of Water Resources
 City, State, ZIP Code: Haviland, KS 67059 Application Number: 39,213

3] LOCATE WELL'S LOCATION WITH AN "X" IN SECTION BOX:

 4] DEPTH OF COMPLETED WELL: 166' ft. ELEVATION:
 Depth(s) Groundwater Encountered 1. ft. 2. ft. 3. ft.
 WELL'S STATIC WATER LEVEL 23' ft. below land surface measured on mo/day/yr
 Pump test data: Well water was not Ch'd ft. after hours pumping gpm
 Est. Yield unknown gpm: Well water was ft. after hours pumping gpm
 Bore Hole Diameter: in. to ft., and in. to ft.
 WELL WATER TO BE USED AS:
 5 Public water supply 8 Air conditioning 11 Injection well
 1 Domestic 3 Feedlot 6 Oil field water supply 9 Dewatering 12 Other (Specify below)
 2 Irrigation 4 Industrial 7 Lawn and garden only 10 Monitoring well
 Was a chemical/bacteriological sample submitted to Department? Yes.....No...X.....; If yes, mo/day/yr sample was submitted
 Water Well Disinfected? Yes No X

5] TYPE OF BLANK CASING USED:
 1 Steel 3 RMP (SR) 5 Wrought iron 8 Concrete tile CASING JOINTS: Glued Clamped
 2 PVC 4 ABS 6 Asbestos-Cement 9 Other (specify below) Welded X
 7 Fiberglass Threaded
 Blank casing diameter 16 in. to 62 ft., Dia 16 in. to 105 ft., Dia in. to ft.
 Casing height above land surface 12 in., weight 42.05 lbs./ft. Wall thickness or gauge No. 250
 TYPE OF SCREEN OR PERFORATION MATERIAL:
 1 Steel 3 Stainless steel 5 Fiberglass 7 PVC 10 Asbestos-cement
 2 Brass 4 Galvanized steel 6 Concrete tile 8 RMP (SR) 11 Other (specify)
 9 ABS 12 None used (open hole)
 SCREEN OR PERFORATION OPENINGS ARE:
 1 Continuous slot 3 Mill slot 5 Gauzed wrapped 8 Saw cut 11 None (open hole)
 2 Louvered shutter 4 Key punched 6 Wire wrapped 9 Drilled holes
 7 Torch cut 10 Other (specify) Bridge Slot
 SCREEN-PERFORATED INTERVALS: From 62 ft. to 82 ft., From ft. to ft.
 From 105 ft. to 165 ft., From ft. to ft.
 GRAVEL PACK INTERVALS: From 20 ft. to 165 ft., From ft. to ft.
 From ft. to ft., From ft. to ft.

6] GROUT MATERIAL: 1 Neat cement 2 Cement grout 3 Bentonite 4 Other
 Grout Intervals: From 0 ft. to 20 ft., From ft. to ft., From ft. to ft.
 What is the nearest source of possible contamination:
 1 Septic tank 4 Lateral lines 7 Pit privy 10 Livestock pens 14 Abandoned water well
 2 Sewer lines 5 Cess pool 8 Sewage lagoon 11 Fuel storage 15 Oil well/Gas well
 3 Watertight sewer lines 6 Seepage pit 9 Feedyard 12 Fertilizer storage 16 Other (specify below)
 13 Insecticide storage None Known
 Direction from well? How many feet?

FROM	TO	LITHOLOGIC LOG	FROM	TO	PLUGGING INTERVALS
0	2	Topsoil, Sandy			
2	26	Clay, Brown, Sandy			
26	33	Sand & Gravel, Fine			
33	80	Sand & Gravel, Fine, Medium, Some Coarse			
80	100	clay, Tan, Streaks of limestone			
100	120	Sand & Gravel, Fine, Medium & coarse			
120	133	Clay, Brown, Soft & Sandy			
133	164	Sand & Gravel, Fine, Medium, some Coarse			
164	165	Clay, Tan			

7] CONTRACTOR'S OR LANDOWNER'S CERTIFICATION: This water well was (1) constructed, (2) reconstructed, or (3) plugged under my jurisdiction and was completed on (mo/day/year) 3/22/91 and this record is true to the best of my knowledge and belief. Kansas Water Well Contractor's License No. 185 This Water Well Record was completed on (mo/day/yr) 4/8/91 under the business name of Clarke Well & Equipment, Inc. by (signature) *[Signature]*

OFFICE USE ONLY
T
R
E/W
SEC.