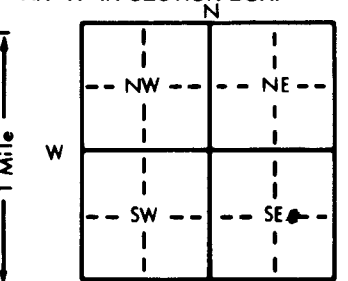


1 LOCATION OF WATER WELL:		Fraction	Section Number	Township Number	Range Number
County: <u>EDWARDS</u>		<u>W 1/2 E 1/2 1/4 SE 1/4</u>	<u>22</u>	T <u>26</u> S	R <u>16</u> E <u>10</u>
Distance and direction from nearest town or city street address of well if located within city? <u>TROUSDALE 2 1/2 S 2 E 3/4 S WESTSIDE</u>					
2 WATER WELL OWNER: <u>D.R. LAUCK OIL CO. INC.</u>					
RR#, St. Address, Box #: <u>221 S. BROADWAY WHITEHALL</u>					
City, State, ZIP Code: <u>WICHITA, KS 67202</u>					
Board of Agriculture, Division of Water Resources Application Number: <u>T85-986</u>					
3 LOCATE WELL'S LOCATION WITH AN "X" IN SECTION BOX:		4 DEPTH OF COMPLETED WELL: <u>75</u> ft. ELEVATION: _____			
		Depth(s) Groundwater Encountered 1. <u>26</u> ft. 2. _____ ft. 3. _____ ft.			
		WELL'S STATIC WATER LEVEL <u>22</u> ft. below land surface measured on mo/day/yr <u>10-30-85</u>			
		Pump test data: Well water was _____ ft. after _____ hours pumping _____ gpm			
		Est. Yield _____ gpm: Well water was _____ ft. after _____ hours pumping _____ gpm			
		Bore Hole Diameter <u>7 7/8</u> in. to <u>75</u> ft., and _____ in. to _____ ft.			
		WELL WATER TO BE USED AS: 5 Public water supply 8 Air conditioning 11 Injection well 1 Domestic 3 Feedlot 6 Oil field water supply 9 Dewatering 12 Other (Specify below) 2 Irrigation 4 Industrial 7 Lawn and garden only 10 Observation well			
		Was a chemical/bacteriological sample submitted to Department? Yes _____ No _____; If yes, mo/day/yr sample was submitted _____			
		Water Well Disinfected? Yes _____ No _____			
5 TYPE OF BLANK CASING USED: 1 Steel 3 RMP (SR) 5 Wrought iron 8 Concrete tile CASING JOINTS: Glued <u>X</u> Clamped _____ 2 <u>PVC</u> 4 ABS 6 Asbestos-Cement 9 Other (specify below) Welded _____ Blank casing diameter <u>6</u> in. to <u>55</u> ft., Dia _____ in. to _____ ft., Dia _____ in. to _____ ft. Casing height above land surface <u>12</u> in., weight <u>2-05</u> lbs./ft. Wall thickness or gauge No. <u>2-14</u>					
TYPE OF SCREEN OR PERFORATION MATERIAL: 1 Steel 3 Stainless steel 5 Fiberglass 7 <u>PVC</u> 10 Asbestos-cement 2 Brass 4 Galvanized steel 6 Concrete tile 8 RMP (SR) 11 Other (specify) _____ SCREEN OR PERFORATION OPENINGS ARE: <u>1/8</u> 1 Continuous slot 3 Mill slot 5 Gauzed wrapped 8 <u>Saw cut</u> 11 None (open hole) 2 Louvered shutter 4 Key punched 6 Wire wrapped 9 Drilled holes SCREEN-PERFORATED INTERVALS: From <u>55</u> ft. to <u>75</u> ft., From _____ ft. to _____ ft. GRAVEL PACK INTERVALS: From <u>45</u> ft. to <u>75</u> ft., From _____ ft. to _____ ft.					
6 GROUT MATERIAL: 1 Neat cement 2 Cement grout 3 <u>Bentonite</u> 4 Other _____ Grout Intervals: From <u>0</u> ft. to <u>10</u> ft., From _____ ft. to _____ ft., From _____ ft. to _____ ft. What is the nearest source of possible contamination: <u>NONE</u> 1 Septic tank 4 Lateral lines 7 Pit privy 10 Livestock pens 14 Abandoned water well 2 Sewer lines 5 Cess pool 8 Sewage lagoon 11 Fuel storage 15 Oil well/Gas well 3 Watertight sewer lines 6 Seepage pit 9 Feedyard 12 Fertilizer storage 16 Other (specify below) Direction from well? _____ How many feet? _____					
FROM TO LITHOLOGIC LOG FROM TO LITHOLOGIC LOG					
<u>0 1 TOP SOIL</u>					
<u>1 6 BROWN SANDY CLAY</u>					
<u>6 13 BROWN & GREY SANDY CLAY</u>					
<u>19 28 BROWN & GREY CLAY - SAND & GRAVEL MIX</u>					
<u>28 58 SAND & GRAVEL</u>					
<u>58 63 YELLOW & GREY CLAY</u>					
<u>63 75 SAND & GRAVEL</u>					
7 CONTRACTOR'S OR LANDOWNER'S CERTIFICATION: This water well was (1) <u>constructed</u> , (2) reconstructed, or (3) plugged under my jurisdiction and was completed on (mo/day/year) <u>10-30-85</u> and this record is true to the best of my knowledge and belief. Kansas Water Well Contractor's License No. <u>389</u> This Water Well Record was completed on (mo/day/yr) <u>11-3-85</u> under the business name of <u>KEISER WATER WELL SERV. INC.</u> by (signature) <u>Rudolph R. Keiser</u>					
INSTRUCTIONS: Use typewriter or ball point pen, PLEASE PRESS FIRMLY and PRINT clearly. Please fill in blanks, underline or circle the correct answers. Send top three copies to Kansas Department of Health and Environment, Division of Environment, Environmental Geology Section, Topeka, KS 66620. Send one to WATER WELL OWNER and retain one for your records.					