


1 LOCATION OF WATER WELL: Fraction $\frac{1}{4}$ C $\frac{1}{4}$ SW $\frac{1}{4}$ Section Number 25 Township Number T 26 S Range Number R 16 E/W
 County: Edwards

Distance and direction from nearest town or city street address of well if located within city?
 3 1/4 east - 4 1/4 south of Trousdale, Ks.

2 WATER WELL OWNER: O. D. Spencer
 RR#, St. Address, Box #: Rt. 1 Box 25
 City, State, ZIP Code: Ulysses, Ks. 67880
 Board of Agriculture, Division of Water Resources
 Application Number: 36,960

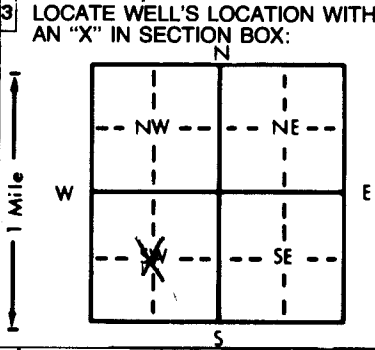

4 DEPTH OF COMPLETED WELL: 189 ft. ELEVATION:
 Depth(s) Groundwater Encountered 1. 28 ft. 2. ft. 3. ft.
 WELL'S STATIC WATER LEVEL: 32 ft. below land surface measured on mo/day/yr 1-25-84
 Pump test data: Well water was 48 ft. after 2 hours pumping 600 gpm
 Est. Yield 1400 gpm: Well water was 1400 ft. after 3 hours pumping 1400 gpm
 Bore Hole Diameter: 29 in. to 189 ft., and in. to ft.
 WELL WATER TO BE USED AS:
 5 Public water supply 8 Air conditioning 11 Injection well
 1 Domestic 3 Feedlot 6 Oil field water supply 9 Dewatering 12 Other (Specify below)
 2 Irrigation 4 Industrial 7 Lawn and garden only 10 Observation well
 Was a chemical/bacteriological sample submitted to Department? Yes No If yes, mo/day/yr sample was submitted
 Water Well Disinfected? Yes hth No

5 TYPE OF BLANK CASING USED:
 1 Steel 3 RMP (SR) 5 Wrought iron 8 Concrete tile CASING JOINTS: Glued Clamped
 2 PVC 4 ABS 6 Asbestos-Cement 9 Other (specify below) Welded
 7 Fiberglass Threaded
 Blank casing diameter 16 in. to 1.29 ft., Dia in. to ft., Dia in. to ft.
 Casing height above land surface 12 in., weight lbs./ft. Wall thickness or gauge No. 7 ga.
 TYPE OF SCREEN OR PERFORATION MATERIAL:
 1 Steel 3 Stainless steel 5 Fiberglass 8 RMP (SR) 10 Asbestos-cement
 2 Brass 4 Galvanized steel 6 Concrete tile 9 ABS 11 Other (specify)
 12 None used (open hole)
 SCREEN OR PERFORATION OPENINGS ARE:
 1 Continuous slot 3 Mill slot 5 Gauzed wrapped 8 Saw cut 11 None (open hole)
 2 Louvered shutter 4 Key punched 6 Wire wrapped 9 Drilled holes
 7 Torch cut 10 Other (specify)
 SCREEN-PERFORATED INTERVALS: From 1.29 ft. to 1.89 ft., From ft. to ft.
 From ft. to ft., From ft. to ft.
 GRAVEL PACK INTERVALS: From 1.0 ft. to 1.89 ft., From ft. to ft.
 From ft. to ft., From ft. to ft.

6 GROUT MATERIAL: 1 Neat cement 2 Cement grout 3 Bentonite 4 Other
 Grout Intervals: From 0 ft. to 10 ft., From ft. to ft., From ft. to ft.
 What is the nearest source of possible contamination:
 1 Septic tank 4 Lateral lines 7 Pit privy 10 Livestock pens 14 Abandoned water well
 2 Sewer lines 5 Cess pool 8 Sewage lagoon 11 Fuel storage 15 Oil well/Gas well
 3 Watertight sewer lines 6 Seepage pit 9 Feedyard 12 Fertilizer storage 16 Other (specify below)
 13 Insecticide storage none
 Direction from well? How many feet?

FROM	TO	LITHOLOGIC LOG	FROM	TO	LITHOLOGIC LOG
0	2	Top soil	132	151	Sand and gravel
2	4	Sand	151	156	Sand and gravel clay layers
4	15	Clay	156	186	Sand and gravel
15	33	Sand clay streaks	186	200	Sand and gravel clay layers
33	48	Sand and gravel			
48	50	Clay			
50	63	Sand and gravel			
63	68	Clay			
68	71	Sand and xxx sandy clay layers			
71	76	clay			
76	81	Sand & gravel with clay layers			
81	93	Sand and gravel			
93	94	Clay			
94	126	Sand and gravel			
126	132	Clay & layers of sand			

7 CONTRACTOR'S OR LANDOWNER'S CERTIFICATION: This water well was (1) constructed, (2) reconstructed, or (3) plugged under my jurisdiction and was completed on (mo/day/year) 5-9-85 and this record is true to the best of my knowledge and belief. Kansas Water Well Contractor's License No. 134 This Water Well Record was completed on (mo/day/yr) 5-15-85 under the business name of Rosencrantz-Bemis by (signature) Fredia Redson

INSTRUCTIONS: Use typewriter or ball point pen, PLEASE PRESS FIRMLY and PRINT clearly. Please fill in blanks, underline or circle the correct answers. Send top three copies to Kansas Department of Health and Environment, Division of Environment, Environmental Geology Section, Topeka, KS 66620. Send one to WATER WELL OWNER and retain one for your records.

OFFICE USE ONLY
T
R
EW
SEC
1/4
1/4
1/4