


FILES #1

1 LOCATION OF WATER WELL: County: EDWARDS. Fraction: N 1/2 1/4 NE 1/4 SW 1/4 Section Number: 27 Township Number: T 26 S Range Number: R 16 E/W

Distance and direction from nearest town or city street address of well if located within city? TROUSSEDALE 3 1/2 S 1 E 1/2 S EASTSIDE.

2 WATER WELL OWNER: J.W. DRILLING CO. INC. EDW. FILES. MACKSVILLE, KS. RR#, St. Address, Box #: 200 E. FIRST SUITE 500 Board of Agriculture, Division of Water Resources City, State, ZIP Code: WICHITA, KS 67202 Application Number: T84-904

3 LOCATE WELL'S LOCATION WITH AN "X" IN SECTION BOX: 4 DEPTH OF COMPLETED WELL: 65 ft. ELEVATION: 1127.84

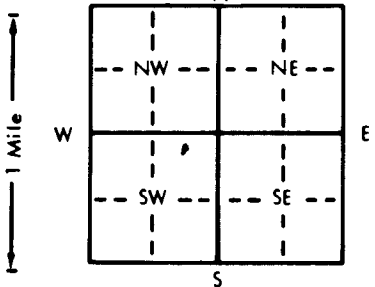

Depth(s) Groundwater Encountered 1. 37 ft. 2. ft. 3. ft. WELL'S STATIC WATER LEVEL 20 ft. below land surface measured on mo/day/yr 1127.84 Pump test data: Well water was ft. after hours pumping gpm Est. Yield gpm Well water was ft. after hours pumping gpm Bore Hole Diameter 7 7/8 in. to 65 ft. and in. to ft. WELL WATER TO BE USED AS: 5 Public water supply 8 Air conditioning 11 Injection well 1 Domestic 3 Feedlot 6 Oil field water supply 9 Dewatering 12 Other (Specify below) 2 Irrigation 4 Industrial 7 Lawn and garden only 10 Observation well Was a chemical/bacteriological sample submitted to Department? Yes No; If yes, mo/day/yr sample was submitted Water Well Disinfected? Yes No

5 TYPE OF BLANK CASING USED: 1 Steel 3 RMP (SR) 5 Wrought iron 8 Concrete tile CASING JOINTS: Glued X Clamped Welded Threaded 2 PVC 4 ABS 6 Asbestos-Cement 9 Other (specify below)

Blank casing diameter 5 in. to 45 ft. Dia. in. to ft. Dia. in. to ft. Casing height above land surface 12 in., weight 2.65 lbs./ft. Wall thickness or gauge No. 216

TYPE OF SCREEN OR PERFORATION MATERIAL: 1 Steel 3 Stainless steel 5 Fiberglass 7 PVC 10 Asbestos-cement 2 Brass 4 Galvanized steel 6 Concrete tile 8 RMP (SR) 11 Other (specify) 12 None used (open hole)

SCREEN OR PERFORATION OPENINGS ARE: 118 5 Gauzed wrapped 8 Saw cut 11 None (open hole) 1 Continuous slot 3 Mill slot 6 Wire wrapped 9 Drilled holes 2 Louvered shutter 4 Key punched 7 Torch cut 10 Other (specify)

SCREEN-PERFORATED INTERVALS: From 45 ft. to 65 ft. GRAVEL PACK INTERVALS: From 35 ft. to 65 ft.

6 GROUT MATERIAL: 1 Neat cement 2 Cement grout 3 Bentonite 4 Other Grout intervals: From 0 ft. to 10 ft.

What is the nearest source of possible contamination: NONE. 1 Septic tank 4 Lateral lines 7 Pit privy 10 Livestock pens 14 Abandoned water well 2 Sewer lines 5 Cess pool 8 Sewage lagoon 11 Fuel storage 15 Oil well/Gas well 3 Watertight sewer lines 6 Seepage pit 9 Feedyard 12 Fertilizer storage 16 Other (specify below) 13 Insecticide storage

Direction from well? How many feet?

Table with columns FROM, TO, LITHOLOGIC LOG. Data: 0-5 FINE SAND, 5-15 CLAY, 15-35 SANDY CLAY, 35-58 GRAVEL, 58-65 SANDY CLAY.

7 CONTRACTOR'S OR LANDOWNER'S CERTIFICATION: This water well was (1) constructed, (2) reconstructed, or (3) plugged under my jurisdiction and was completed on (mo/day/year) 11.27.84 and this record is true to the best of my knowledge and belief. Kansas Water Well Contractor's License No. 389 This Water Well Record was completed on (mo/day/yr) 12.5.84 under the business name of KEISER WATER WELL SERV. INC. by (signature) Paul J. Keiser

INSTRUCTIONS: Use typewriter or ball point pen, PLEASE PRESS FIRMLY and PRINT clearly. Please fill in blanks, underline or circle the correct answers. Send top three copies to Kansas Department of Health and Environment, Division of Environment, Environmental Geology Section, Topeka, KS 66620. Send one to WATER WELL OWNER and retain one for your records.

OFFICE USE ONLY T R E/W SEC. 1/4 1/4 1/4