


1 LOCATION OF WATER WELL: ; Fraction ; Section Number ; Township Number ; Range Number
 COUNTY: 024 EDWARDS ; SW 1/4 SW 1/4 NW 1/4 ; 30 ; T 26 S ; R 16 W

Distance and direction from nearest town or city street address of well if located within city?
 3 1/2 S. 2 W. OF TROUSDALE, KANS.

2 WATER WELL OWNER: STEVENS, MARION 038
 RR#, St. Address, Box #: R.R.1 Board of Agriculture, Division of Water Resources
 City, State, ZIP code : HAVILAND, KS 67059- Application Number:

3 LOCATE WELL'S LOCATION WITH AN "X" IN SECTION BOX: 4 DEPTH OF COMPLETED WELL 100 ELEVATION:
 Depth(s) Groundwater Encountered 1. 22 ft. 2. ft. 3. ft.

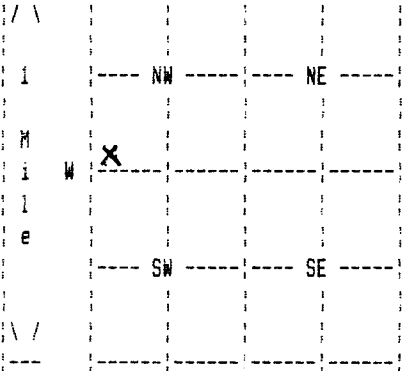

WELL'S STATIC WATER LEVEL 22 ft. below land surface measured on mo/day/yr 9 /5 /90
 Pump test data: Well water was ft. after hours pumping gpm
 Estimated Yield gpm: Well water was ft. after hours pumping gpm
 Bore Hole Diameter 8.75 in. to 100 ft., and in. to ft.
 WELL WATER TO BE USED AS: 01 DOMESTIC
 Was a chemical/bacteriological sample submitted to department? No ;
 If yes, mo/day/yr sample was submitted Water well disinfected? Yes

5 TYPE OF BLANK CASING USED: 02 PVC CASING JOINTS: GLUED
 Blank casing diameter 5 in. to 80 ft., Dia in. to ft., Dia in. to ft.
 Casing height above land surface 12 in., weight lbs/ft. Wall thickness or gauge No. 26
 TYPE OF SCREEN OR PERFORATION MATERIAL: 07 PVC
 SCREEN OR PERFORATION OPENINGS ARE: 08 SAN CUT

SCREEN PERFORATED INTERVALS: From 80 ft. to 100 ft., From ft. to ft.
 From ft. to ft., From ft. to ft.
 GRAVEL PACK INTERVALS: From 25 ft. to 100 ft., From ft. to ft.
 From ft. to ft., From ft. to ft.

6 GROUT MATERIAL 03 BENTONITE
 Grout Intervals: From 4 ft. to 25 ft., From ft. to ft., From ft. to ft.
 What is the nearest source of possible contamination: 01 SEPTIC TANK
 Direction from well? S.W. How many feet? 75

| FROM | TO | LITHOLOGIC LOG | FROM | TO | PLUGGING INTERVALS |
|------|-----|-----------------------|------|----|--------------------|
| 1 | 6 | SILT & SAND | | | |
| 6 | 15 | TAN CLAY | | | |
| 15 | 23 | GREY CLAY | | | |
| 23 | 45 | SAND & CLAY | | | |
| 45 | 100 | 05 SAND AND 17 GRAVEL | | | |

7 CONTRACTOR'S OR LANDOWNER'S CERTIFICATION: This water well was Constructed under my jurisdiction and was completed on (mo/day/year) 9 /5 /90 and this record is true to the best of my knowledge and belief. Kansas Water Well Contractor's License No. 224 This Water Well Record was completed on (mo/day/yr) 06/28/91 under the business name of CARL HAYSE WATER WELL SVC by (signature) *Carl Hayse*