


1 LOCATION OF WATER WELL: Fraction SE 1/4 SE 1/4 NW 1/4 Section Number 36 Township Number T 26 S Range Number R 16 EW  
 County: Edwards

Distance and direction from nearest town or city street address of well if located within city?  
3 1/2 E 55 Transdale Kansas

2 WATER WELL OWNER: Ron Schultz  
 RR#, St. Address, Box # :  
 City, State, ZIP Code : Macksville Kansas  
 Board of Agriculture, Division of Water Resources  
 Application Number:

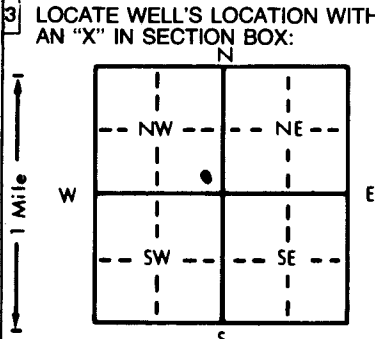

4 DEPTH OF COMPLETED WELL: 60 ft. ELEVATION:  
 Depth(s) Groundwater Encountered 1. 24 ft. 2. . . . . ft. 3. . . . . ft.  
 WELL'S STATIC WATER LEVEL 24 ft. below land surface measured on mo/day/yr 3-2-84  
 Pump test data: Well water was 24 ft. after 1 hours pumping 3 gpm  
 Est. Yield 15 gpm; Well water was . . . . . ft. after . . . . . hours pumping . . . . . gpm  
 Bore Hole Diameter 8 3/4 in. to 60 . . . . . ft., and . . . . . in. to . . . . . ft.  
 WELL WATER TO BE USED AS:  
 1 Domestic     2 Irrigation     3 Feedlot     4 Industrial  
 5 Public water supply     6 Oil field water supply     7 Lawn and garden only  
 8 Air conditioning     9 Dewatering     10 Observation well  
 11 Injection well     12 Other (Specify below)  
 Was a chemical/bacteriological sample submitted to Department? Yes . . . . . No  . . . . .  
 If yes, mo/day/yr sample was submitted  
 Water Well Disinfected? Yes  No

5 TYPE OF BLANK CASING USED:  
 1 Steel     3 RMP (SR)     5 Wrought iron     8 Concrete tile    CASING JOINTS: Glued  Clamped . . . . .  
 2 PVC     4 ABS     6 Asbestos-Cement     9 Other (specify below)    Welded . . . . .  
 7 Fiberglass    Threaded . . . . .  
 Blank casing diameter 5 in. to 40 ft., Dia . . . . . in. to . . . . . ft., Dia . . . . . in. to . . . . . ft.  
 Casing height above land surface 16 in., weight . . . . . lbs./ft. Wall thickness or gauge No. SDR-26

TYPE OF SCREEN OR PERFORATION MATERIAL:  
 1 Steel     3 Stainless steel     5 Fiberglass     8 RMP (SR)     10 Asbestos-cement  
 2 Brass     4 Galvanized steel     6 Concrete tile     9 ABS     11 Other (specify) . . . . .  
 12 None used (open hole)

SCREEN OR PERFORATION OPENINGS ARE:  
 1 Continuous slot     3 Mill slot     5 Gauzed wrapped     8 Saw cut     11 None (open hole)  
 2 Louvered shutter     4 Key punched     6 Wire wrapped     9 Drilled holes  
 7 Torch cut     10 Other (specify) . . . . .

SCREEN-PERFORATED INTERVALS: From 40 ft. to 60 . . . . . ft., From . . . . . ft. to . . . . . ft.  
 From . . . . . ft. to . . . . . ft., From . . . . . ft. to . . . . . ft.  
 GRAVEL PACK INTERVALS: From 25 ft. to 60 . . . . . ft., From . . . . . ft. to . . . . . ft.  
 From . . . . . ft. to . . . . . ft., From . . . . . ft. to . . . . . ft.

6 GROUT MATERIAL:  1 Neat cement     2 Cement grout     3 Bentonite     4 Other . . . . .  
 Grout intervals: From 0 . . . . . ft. to 10 . . . . . ft., From . . . . . ft. to . . . . . ft., From . . . . . ft. to . . . . . ft.

What is the nearest source of possible contamination:  
 1 Septic tank     4 Lateral lines     7 Pit privy     10 Livestock pens     14 Abandoned water well  
 2 Sewer lines     5 Cess pool     8 Sewage lagoon     11 Fuel storage     15 Oil well/Gas well  
 3 Watertight sewer lines     6 Seepage pit     9 Feedyard     12 Fertilizer storage     16 Other (specify below)  
PASTURE

Direction from well? How many feet?

FROM	TO	LITHOLOGIC LOG	FROM	TO	LITHOLOGIC LOG
0	2	Top Soil			
2	10	Clay			
10	12	Sand			
12	22	Clay			
22	60	Gravel			

7 CONTRACTOR'S OR LANDOWNER'S CERTIFICATION: This water well was  (1) constructed,  (2) reconstructed, or  (3) plugged under my jurisdiction and was completed on (mo/day/year) 3-2-84 and this record is true to the best of my knowledge and belief. Kansas Water Well Contractor's License No. 324 This Water Well Record was completed on (mo/day/yr) 7-31-84 under the business name of Carl Kaye Water Well Serv by (signature) Carl Kaye

INSTRUCTIONS: Use typewriter or ball point pen, PLEASE PRESS FIRMLY and PRINT clearly. Please fill in blanks, underline or circle the correct answers. Send top three copies to Kansas Department of Health and Environment, Division of Environment, Environmental Geology Section, Topeka, KS 66620. Send one to WATER WELL OWNER and retain one for your records.

OFFICE USE ONLY  
T  
R  
EW  
SEC.