


WATER WELL RECORD Form WWC-5 KSA 82a-1212

1 LOCATION OF WATER WELL: Fraction Section Number Township Number Range Number  
 COUNTY: EDWARDS SE 1/4 NW 1/4 NE 1/4 10 T 26 S R 16 W

Distance and direction from nearest town or city street address of well if located within city?  
 1/2 MILE SOUTH, 1 1/2 MILES EAST, 1/4 MILE SOUTH OF TROUSDALE

2 WATER WELL OWNER: SCHULTZ, RON  
 RR#, St. Address, Box #: RT. 1 BOX 77A Board of Agriculture, Division of Water Resources  
 City, State, ZIP code: HAVILAND, KS 67059- Application Number:

3 LOCATE WELL'S LOCATION WITH AN "X" IN SECTION BOX:

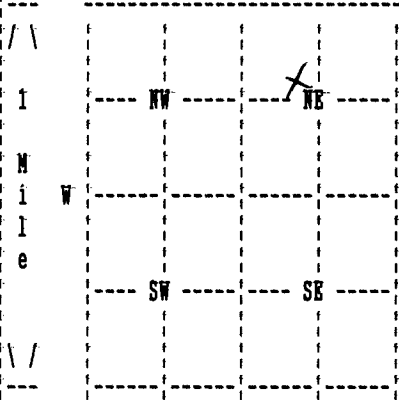

4 DEPTH OF COMPLETED WELL 61 ELEVATION: 0  
 Depth(s) Groundwater Encountered 1. 0 ft. 2. 0 ft. 3. 0 ft.

WELL'S STATIC WATER LEVEL 12 ft. below land surface measured on mo/day/yr 01/08/01  
 Pump test data: Well water was 0 ft. after 0 hours pumping 0 gpm

Estimated Yield 100 gpm: Well water was 0 ft. after 0 hours pumping 0 gpm

Bore Hole Diameter 8.75 in. to 61 ft., and in. to 0 ft.

WELL WATER TO BE USED AS: LIVESTOCK

Was a chemical/bacteriological sample submitted to department? No;  
 If yes, mo/day/yr sample was submitted Water well disinfected? Yes

5 TYPE OF BLANK CASING USED: PVC CASING JOINTS: GLUED  
 Blank casing diameter 5 in. to 51 ft., Dia in. to 0 ft., Dia in. to 0 ft.  
 Casing height above land surface 24 in., weight 0 lbs/ft. Wall thickness or gauge No. 26  
 TYPE OF SCREEN OR PERFORATION MATERIAL: PVC  
 SCREEN OR PERFORATION OPENINGS ARE: SAW CUT

SCREEN PERFORATED INTERVALS: From 51 ft. to 61 ft., From 0 ft. to 0 ft.  
 From 0 ft. to 0 ft., From 0 ft. to 0 ft.  
 GRAVEL PACK INTERVALS: From 21 ft. to 61 ft., From 0 ft. to 0 ft.  
 From 0 ft. to 0 ft., From 0 ft. to 0 ft.

6 GROUT MATERIAL BENTONITE  
 Grout Intervals: From 1 ft. to 21 ft., From 0 ft. to 0 ft., From 0 ft. to 0 ft.  
 What is the nearest source of possible contamination: OIL/GAS WELL  
 Direction from well? NORTH How many feet? 1500

FROM	TO	LITHOLOGIC LOG	FROM	TO	PLUGGING INTERVALS
0	5	SILT AND SAND			
5	18	TAN CLAY			
18	27	WHITE CLAY			
27	35	TAN CLAY			
35	41	SAND AND GRAVEL			
41	45	TAN CLAY			
45	61	SAND AND GRAVEL			

7 CONTRACTOR'S OR LANDOWNER'S CERTIFICATION: This water well was Constructed under my jurisdiction and was completed on (mo/day/year) 01/08/01 and this record is true to the best of my knowledge and belief. Kansas Water Well Contractor's License No. 653 This Water Well Record was completed on (mo/day/yr) 02/01/02 under the business name of DAN HAYSE WATER WELL SVC. by (signature) Dan Hayse