


WATER WELL RECORD Form WWC-5 KSA 82a-1212

1 LOCATION OF WATER WELL: Fraction Section Number Township Number Range Number
COUNTY: EDWARDS NW 1/4 NE 1/4 NW 1/4 16 T 26 S R 16 W

Distance and direction from nearest town or city street address of well if located within city?
1 1/2 MILES SOUTH, 1/4 MILE EAST OF TROUSDALE

2 WATER WELL OWNER: MONAGHAN, GLENN
RR#, St. Address, Box #: RR 1 BOX 71
City, State, ZIP code: HAVILAND, KS 67059-
Board of Agriculture, Division of Water Resources
Application Number:

3 LOCATE WELL'S LOCATION WITH AN "X" IN SECTION BOX:

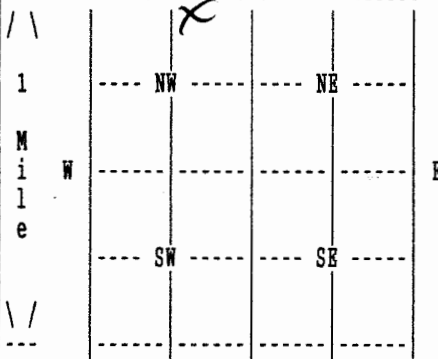

4 DEPTH OF COMPLETED WELL 80 ELEVATION: 0
Depth(s) Groundwater Encountered 1. 0 ft. 2. 0 ft. 3. 0 ft.

WELL'S STATIC WATER LEVEL 17 ft. below land surface measured on mo/day/yr 08/02/04
Pump test data: Well water was 0 ft. after 0 hours pumping 0 gpm
Estimated Yield 0 gpm: Well water was 0 ft. after 0 hours pumping 0 gpm

Bore Hole Diameter 8.75 in. to 80 ft., and in. to 0 ft.

WELL WATER TO BE USED AS: LIVESTOCK

Was a chemical/bacteriological sample submitted to department? No;
If yes, mo/day/yr sample was submitted Water well disinfected? Yes

5 TYPE OF BLANK CASING USED: PVC CASING JOINTS: GLUED
Blank casing diameter 5 in. to 70 ft., Dia in. to 0 ft., Dia in. to 0 ft.
Casing height above land surface 12 in., weight 0 lbs/ft. Wall thickness or gauge No. 26
TYPE OF SCREEN OR PERFORATION MATERIAL: PVC
SCREEN OR PERFORATION OPENINGS ARE: SAW CUT

SCREEN PERFORATED INTERVALS: From 70 ft. to 80 ft., From 0 ft. to 0 ft.
From 0 ft. to 0 ft., From 0 ft. to 0 ft.
GRAVEL PACK INTERVALS: From 23 ft. to 80 ft., From 0 ft. to 0 ft.
From 0 ft. to 0 ft., From 0 ft. to 0 ft.

6 GROUT MATERIAL BENTONITE
Grout Intervals: From 1 ft. to 23 ft., From 0 ft. to 0 ft., From 0 ft. to 0 ft.
What is the nearest source of possible contamination: SEPTIC TANK
Direction from well? WEST How many feet? 2000

Table with columns: FROM, TO, LITHOLOGIC LOG, FROM, TO, PLUGGING INTERVALS. Rows describe geological layers: SILT AND SAND, SAND, TAN CLAY, SAND AND GRAVEL, TAN CLAY, SAND AND GRAVEL.

7 CONTRACTOR'S OR LANDOWNER'S CERTIFICATION: This water well was Constructed under my jurisdiction and was completed on (mo/day/year) 08/02/04 and this record is true to the best of my knowledge and belief. Kansas Water Well Contractor's License No. 653 This Water Well Record was completed on (mo/day/yr) 09/22/04 under the business name of DAN HAYSE WATER WELL SERV by (signature) Dan Hayse