


1 LOCATION OF WATER WELL: Fraction NE 1/4 Section Number 2 Township Number T 26 S Range Number R 17 E/W  
County: EDWARDS

Distance and direction from nearest town or city street address of well if located within city?  
1/2 E 1/4 N. Fellsburg, Kans.

2 WATER WELL OWNER: Floyd C Rockett  
RR#, St. Address, Box #: Lewis Kansas  
City, State, ZIP Code: Lewis Kansas  
Board of Agriculture, Division of Water Resources  
Application Number:

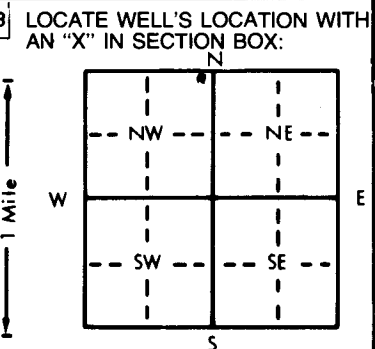

4 DEPTH OF COMPLETED WELL: 78 ft. ELEVATION:  
Depth(s) Groundwater Encountered 1. 36 ft. 2. 36 ft. 3. 36 ft.  
WELL'S STATIC WATER LEVEL 36 ft. below land surface measured on mo/day/yr 3-22-83  
Pump test data: Well water was 36 ft. after 1 hours pumping 10 gpm  
Est. Yield 25 gpm; Well water was 36 ft. after 1 hours pumping 10 gpm  
Bore Hole Diameter: 8 3/4 in. to 7 8 ft., and 7 8 in. to 7 8 ft.  
WELL WATER TO BE USED AS:  
 1 Domestic  3 Feedlot  6 Oil field water supply  9 Dewatering  12 Other (Specify below)  
 2 Irrigation  4 Industrial  7 Lawn and garden only  10 Observation well  
Was a chemical/bacteriological sample submitted to Department? Yes X No X; If yes, mo/day/yr sample was submitted X No X  
Water Well Disinfected? Yes X No X

5 TYPE OF BLANK CASING USED:  
1 Steel  3 RMP (SR)  5 Wrought iron  8 Concrete tile  CASING JOINTS: Glued X Clamped X  
2 PVC  4 ABS  6 Asbestos-Cement  9 Other (specify below)  Welded X  
7 Fiberglass  Threaded X  
Casing height above land surface 12 in., weight 12 lbs./ft. Wall thickness or gauge No. SDR-26

TYPE OF SCREEN OR PERFORATION MATERIAL:  
1 Steel  3 Stainless steel  5 Fiberglass  7 PVC  10 Asbestos-cement   
2 Brass  4 Galvanized steel  6 Concrete tile  9 ABS  11 Other (specify)  12 None used (open hole)   
SCREEN OR PERFORATION OPENINGS ARE:  
1 Continuous slot  3 Mill slot  5 Gauzed wrapped  8 Saw cut  11 None (open hole)   
2 Louvered shutter  4 Key punched  6 Wire wrapped  9 Drilled holes   
3 Torch cut   
10 Other (specify)   

What is the nearest source of possible contamination:  
 1 Septic tank  4 Lateral lines  7 Pit privy  10 Livestock pens  14 Abandoned water well  
 2 Sewer lines  5 Cess pool  8 Sewage lagoon  11 Fuel storage  15 Oil well/Gas well  
 3 Watertight sewer lines  6 Seepage pit  9 Feedyard  12 Fertilizer storage  16 Other (specify below)  
 13 Insecticide storage   
Direction from well? SW How many feet? 80

FROM	TO	LITHOLOGIC LOG	FROM	TO	LITHOLOGIC LOG
<u>0</u>	<u>3</u>	<u>Top Soil</u>			
<u>3</u>	<u>25</u>	<u>Clay</u>			
<u>25</u>	<u>78</u>	<u>GRAVEL</u>			

7 CONTRACTOR'S OR LANDOWNER'S CERTIFICATION: This water well was  (1) constructed, (2) reconstructed, or (3) plugged under my jurisdiction and was completed on (mo/day/year) 3-22-83 and this record is true to the best of my knowledge and belief. Kansas Water Well Contractor's License No. 2247 This Water Well Record was completed on (mo/day/yr) 3-23-83 under the business name of Carl Haysel Water Well Serv by (signature) Carl Haysel

INSTRUCTIONS: Use typewriter or ball point pen, PLEASE PRESS FIRMLY and PRINT clearly. Please fill in blanks, underline or circle the correct answers. Send top three copies to Kansas Department of Health and Environment, Division of Environment, Environmental Geology Section, Topeka, KS 66620. Send one to WATER WELL OWNER and retain one for your records.

OFFICE USE ONLY  
T  
26  
R  
17  
E/W  
SEC  
2  
NE 1/4  
NE 1/4  
NW 1/4  
NW 1/4