


1 LOCATION OF WATER WELL: County: EDWARDS Fraction NW 1/4 NW 1/4 NE 1/4 Section Number 2 Township Number T 26 S Range Number R 17 E/W

Distance and direction from nearest town or city street address of well, if located within city? 1 1/2 E 3/4 N. Fallsburg Kansas

2 WATER WELL OWNER: Floyd Crockett RR#, St. Address, Box #: Lewis Kansas City, State, ZIP Code: Board of Agriculture, Division of Water Resources Application Number:

3 LOCATE WELL'S LOCATION WITH AN "X" IN SECTION BOX:

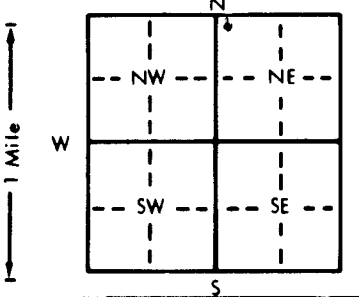

4 DEPTH OF COMPLETED WELL: 80 ft. ELEVATION: Depth(s) Groundwater Encountered 1. 35 ft. 2. 35 ft. 3. WELL'S STATIC WATER LEVEL 35 ft. below land surface measured on mo/day/yr 5-11-82 Pump test data: Well water was 35 ft. after 1 hours pumping 10 gpm Est. Yield 25 gpm Well water was Bore Hole Diameter 8 3/4 in. to 80 in. to WELL WATER TO BE USED AS: 5 Public water supply 8 Air conditioning 11 Injection well 1 Domestic 3 Feedlot 6 Oil field water supply 9 Dewatering 12 Other (Specify below) 2 Irrigation 4 Industrial 7 Lawn and garden only 10 Observation well Was a chemical/bacteriological sample submitted to Department? Yes No X If yes, mo/day/yr sample was submitted Water Well Disinfected? Yes X No

5 TYPE OF BLANK CASING USED: 1 Steel 2 PVC 3 RMP (SR) 4 ABS 5 Wrought iron 6 Asbestos-Cement 7 Fiberglass 8 Concrete tile 9 Other (specify below) CASING JOINTS: Glued X Clamped Welded Threaded

Blank casing diameter 5 in. to 60 ft., Dia Casing height above land surface 12 in., weight lbs./ft. Wall thickness or gauge No SDR-26

TYPE OF SCREEN OR PERFORATION MATERIAL: 1 Steel 2 Brass 3 Stainless steel 4 Galvanized steel 5 Fiberglass 6 Concrete tile 7 PVC 8 RMP (SR) 9 ABS 10 Asbestos-cement 11 Other (specify) 12 None used (open hole)

SCREEN OR PERFORATION OPENINGS ARE: 1 Continuous slot 2 Louvered shutter 3 Mill slot 4 Key punched 5 Gauzed wrapped 6 Wire wrapped 7 Torch cut 8 Saw cut 9 Drilled holes 10 Other (specify) 11 None (open hole)

SCREEN-PERFORATED INTERVALS: From 60 ft. to 80 ft. GRAVEL PACK INTERVALS: From 45 ft. to 80 ft.

6 GROUT MATERIAL: 1 Neat cement 2 Cement grout 3 Bentonite 4 Other Grout Intervals: From 4 ft. to 14 ft.

What is the nearest source of possible contamination: 1 Septic tank 2 Sewer lines 3 Watertight sewer lines 4 Lateral lines 5 Cess pool 6 Seepage pit 7 Pit privy 8 Sewage lagoon 9 Feedyard 10 Livestock pens 11 Fuel storage 12 Fertilizer storage 13 Insecticide storage 14 Abandoned water well 15 Oil well/Gas well 16 Other (specify below)

Direction from well? S.E. How many feet? 150

Table with columns FROM, TO, LITHOLOGIC LOG. Row 1: 0, 3, Top Soil. Row 2: 3, 24, Tan Clay. Row 3: 24, 80, Gravel.

7 CONTRACTOR'S OR LANDOWNER'S CERTIFICATION: This water well was (1) constructed, (2) reconstructed, or (3) plugged under my jurisdiction and was completed on (mo/day/year) 5-11-82 and this record is true to the best of my knowledge and belief. Kansas Water Well Contractor's License No. 224 This Water Well Record was completed on (mo/day/yr) 8-11-82 under the business name of Carl Hayes Water Well Serv by (signature) Carl Hayes

INSTRUCTIONS: Use typewriter or ball point pen, PLEASE PRESS FIRMLY and PRINT clearly. Please fill in blanks, underline or circle the correct answers. Send top three copies to Kansas Department of Health and Environment, Division of Environment, Environmental Geology Section, Topeka, KS 66620. Send one to WATER WELL OWNER and retain one for your records.

X- JUL 2 1982

OFFICE USE ONLY T 26 R 17 E/W SEC. 2