


1 LOCATION OF WATER WELL: Fraction NW 1/4 NW 1/4 NE 1/4 Section Number 2 Township Number T 26 S Range Number R 17  
 County: Edwards

Distance and direction from nearest town or city street address of well if located within city?  
8 S. 6 E Lewis Kansas

2 WATER WELL OWNER: Floyd Crockett  
 RR#, St. Address, Box #: Lewis Kans  
 City, State, ZIP Code: Lewis Kans  
 Board of Agriculture, Division of Water Resources  
 Application Number:

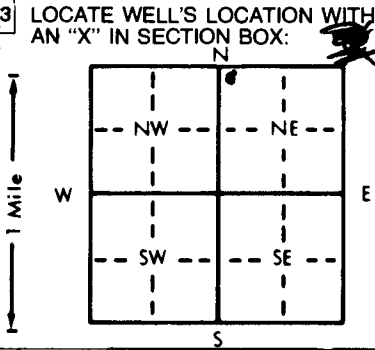

4 DEPTH OF COMPLETED WELL: 80 ft. ELEVATION: 35 ft.  
 WELL'S STATIC WATER LEVEL: 35 ft. below land surface measured on mo/day/yr 7-25-83  
 Pump test data: Well water was 35 ft. after 1 hours pumping 10 gpm  
 Est. Yield 25 gpm; Well water was 35 ft. after 1 hours pumping 10 gpm  
 Bore Hole Diameter: 8 3/4 in. to 80 ft. and 80 in. to 80 ft.  
 WELL WATER TO BE USED AS:  
 Domestic     Feedlot     Oil field water supply     Dewatering     Injection well  
 Irrigation     Industrial     Lawn and garden only     Observation well  
 Was a chemical/bacteriological sample submitted to Department? Yes X No X; If yes, mo/day/yr sample was submitted  
 Water Well Disinfected? Yes X No X

5 TYPE OF BLANK CASING USED:  
 1 Steel     3 RMP (SR)    5 Wrought iron    8 Concrete tile    CASING JOINTS: Glued X Clamped X  
 2 PVC    4 ABS    6 Asbestos-Cement    9 Other (specify below)    Welded X  
 7 Fiberglass    Threaded X  
 Casing height above land surface 12 in., weight 12 lbs./ft. Wall thickness or gauge No. SDR-26

TYPE OF SCREEN OR PERFORATION MATERIAL:  
 1 Steel    3 Stainless steel    5 Fiberglass     8 RMP (SR)    10 Asbestos-cement  
 2 Brass    4 Galvanized steel    6 Concrete tile    9 ABS    11 Other (specify) SDR-26  
 12 None used (open hole)

SCREEN OR PERFORATION OPENINGS ARE:  
 1 Continuous slot    3 Mill slot    5 Gauzed wrapped     8 Saw cut    11 None (open hole)  
 2 Louvered shutter    4 Key punched    6 Wire wrapped    9 Drilled holes  
 7 Torch cut    10 Other (specify) SDR-26



What is the nearest source of possible contamination:  
 1 Septic tank    4 Lateral lines    7 Pit privy    10 Livestock pens    14 Abandoned water well  
 2 Sewer lines    5 Cess pool    8 Sewage lagoon    11 Fuel storage    15 Oil well/Gas well  
 3 Watertight sewer lines    6 Seepage pit    9 Feedyard    12 Fertilizer storage    16 Other (specify below)  
 13 Insecticide storage  
 Direction from well? NW How many feet? 60

FROM	TO	LITHOLOGIC LOG	FROM	TO	LITHOLOGIC LOG
0	10	Top Soil			
1	16	Sandy Clay			
16	30	Reddish Clay			
30	38	Yellow-Gray Clay			
38	54	GRAY			
54	56	White Clay			
56	80	GRAVEL			

7 CONTRACTOR'S OR LANDOWNER'S CERTIFICATION: This water well was  (1) constructed, (2) reconstructed, or (3) plugged under my jurisdiction and was completed on (mo/day/year) 7-25-83 and this record is true to the best of my knowledge and belief. Kansas Water Well Contractor's License No. 224 This Water Well Record was completed on (mo/day/yr) 10-21-83 under the business name of Carl Hayes Water Well Serv. by (signature) Carl Hayes  
 INSTRUCTIONS: Use typewriter or ball point pen, PLEASE PRESS FIRMLY and PRINT clearly. Please fill in blanks, underline or circle the correct answers. Send top three copies to Kansas Department of Health and Environment, Division of Environment, Environmental Geology Section, Topeka, KS 66620. Send one to WATER WELL OWNER and retain one for your records.

OFFICE USE ONLY  
T  
R  
17  
SEC.  
NW 1/4  
NW 1/4  
NE 1/4

D