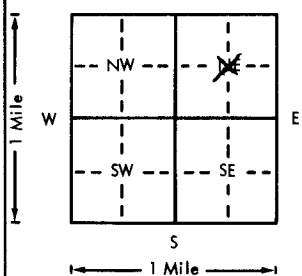


USE TYPEWRITER OR BALL POINT PEN-PRESS FIRMLY, PRINT CLEARLY.

WATER WELL RECORD  
KSA 82a-1201-1215

Kansas Department of Health and Environment-Division of Environment  
(Water well Contractors)  
Topeka, Kansas 66620

*Mayhew Green #1*

1. Location of well:	County <i>Edwards</i>	Fraction <i>C NE 1/4</i> <small>1/4 1/4 1/4</small>	Section number <i>5</i>	Township number <i>T 26 S</i>	Range number <i>R 17 W E/W</i>
2. Distance and direction from nearest town or city: <i>1 mi west 1/2 mi northy Feldsburg.</i>			3. Owner of well: <i>Danne &amp; Gardner</i> R.R. or street: <i>Wichita Kansas.</i> City, state, zip code:		
4. Locate with "X" in section below: N  W E S 1 Mile			6. Bore hole dia. <i>8</i> in. Completion date <i>1-24-78</i> Well depth <i>90</i> ft.		
5. Type and color of material			7. <input type="checkbox"/> Cable tool <input checked="" type="checkbox"/> Rotary <input type="checkbox"/> Driven <input type="checkbox"/> Dug <input type="checkbox"/> Hollow rod <input type="checkbox"/> Jetted <input type="checkbox"/> Bored <input type="checkbox"/> Reverse rotary		
			8. Use: <input type="checkbox"/> Domestic <input type="checkbox"/> Public supply <input type="checkbox"/> Industry <input type="checkbox"/> Irrigation <input type="checkbox"/> Air conditioning <input type="checkbox"/> Stock <input type="checkbox"/> Lawn <input checked="" type="checkbox"/> Oil field water <input type="checkbox"/> Other		
From			9. Casing: Material <i>Plastic</i> Height: <input checked="" type="checkbox"/> Above <input type="checkbox"/> or below		
			Threaded <input type="checkbox"/> Welded <input checked="" type="checkbox"/> Surface <i>12</i> in. RMP <input type="checkbox"/> PVC <input checked="" type="checkbox"/> Weight <i>287.3</i> lbs./ft. Dia. <i>5</i> in. to <i>90</i> ft. depth Wall Thickness: inches or Dia. <input type="checkbox"/> in. to <input type="checkbox"/> ft. depth gage No. <i>200</i>		
To			10. Screen: Manufacturer's name <i>Self-made</i>		
			Type <i>PVC</i> Dia. <i>5</i> Slot/gauze <i>1/8</i> Length <i>20</i> Set between <i>70</i> ft. and <i>90</i> ft. <input type="checkbox"/> ft. and <input type="checkbox"/> ft. Gravel pack? <i>yes</i> Size range of material <i>1/4 - 1/2</i>		
Clay 0 10			11. Static water level: <i>26</i> ft. below land surface Date <i>2-24-78</i>		
			12. Pumping level below land surfaces: ____ ft. after ____ hrs. pumping ____ g.p.m. ____ ft. after ____ hrs. pumping ____ g.p.m. Estimated maximum yield ____ g.p.m.		
Sandy Clay 10 20			13. Water sample submitted: <i>no./day/yr.</i>		
			____ Yes <input checked="" type="checkbox"/> No Date ____		
Sand 20 50			14. Well head completion: <input type="checkbox"/> Pitless adapter ____ Inches above grade		
			15. Well grouted? <i>yes</i> With: <input type="checkbox"/> Neat cement <input checked="" type="checkbox"/> Bentonite <input type="checkbox"/> Concrete Depth: From <i>0</i> ft. to <i>60</i> ft.		
Clay 50 55			16. Nearest source of possible contamination: ft. ____ Direction ____ Type ____ Well disinfected upon completion? ____ Yes ____ No		
			17. Pump: <input checked="" type="checkbox"/> Not installed Manufacturer's name ____ Model number ____ HP ____ Volts ____ Length of drop pipe ____ ft. capacity ____ g.p.m. Type: <input type="checkbox"/> Submersible <input type="checkbox"/> Turbine <input type="checkbox"/> Jet <input type="checkbox"/> Reciprocating <input type="checkbox"/> Centrifugal <input type="checkbox"/> Other		
Sand 55 75			18. Elevation:		
			19. Remarks:		
Gravel 75 90			20. Water well contractor's certification: This well was drilled under my jurisdiction and this report is true to the best of my knowledge and belief. <i>Myers Water Well 148</i> Business name <i>St Bend Ks</i> License No. ____ Address <i>St Bend Ks</i> Signed <i>A Myers</i> Date <i>2-24-78</i> Authorized representative		
			(Use a second sheet if needed)		

T 26 S R 17 W E CNE

Forward the white, blue and pink copies to the Department of Health and Environment

Form WWC-5