


1 LOCATION OF WATER WELL: Fraction SE 1/4 SE 1/4 SE 1/4 Section Number 8 Township Number T 26 S Range Number R 17 (EW)

Distance and direction from nearest town or city street address of well if located within city?  
1 1/4 miles south 1 mile west of Fellsburg

2 WATER WELL OWNER: Tom Stejskal  
 RR#, St. Address, Box # :  
 City, State, ZIP Code : Lewis Kansas 67552 Board of Agriculture, Division of Water Resources  
 Application Number:

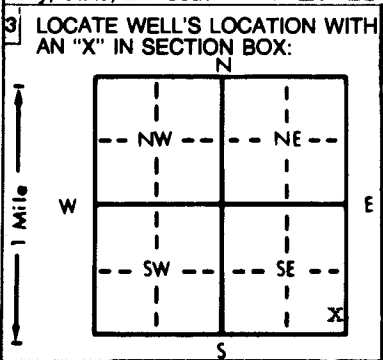

4 DEPTH OF COMPLETED WELL: 113 ft. ELEVATION: .....  
 Depth(s) Groundwater Encountered 1. 28 ft. 2. .... ft. 3. .... ft.  
 WELL'S STATIC WATER LEVEL 28 ft. below land surface measured on mo/day/yr 10/3/88  
 Pump test data: Well water was 60 ft. after 1/2 hours pumping 70 gpm  
 Est. Yield 70 gpm: Well water was ..... ft. after ..... hours pumping ..... gpm  
 Bore Hole Diameter 8 3/4 in. to 113 ft., and ..... in. to ..... ft.  
 WELL WATER TO BE USED AS: 5 Public water supply 8 Air conditioning 11 Injection well  
 Domestic 3 Feedlot 6 Oil field water supply 9 Dewatering 12 Other (Specify below)  
 2 Irrigation 4 Industrial 7 Lawn and garden only 10 Observation well  
 Was a chemical/bacteriological sample submitted to Department? Yes.....No........; If yes, mo/day/yr sample was submitted  
 Water Well Disinfected? Yes  No

5 TYPE OF BLANK CASING USED: 5 Wrought iron 8 Concrete tile CASING JOINTS: Glued  Clamped .....  
 1 Steel 3 RMP (SR) 6 Asbestos-Cement 9 Other (specify below) Welded .....  
 2 PVC 4 ABS 7 Fiberglass ..... Threaded.....  
 Blank casing diameter 5 in. to 9 3/8 ft., Dia ..... in. to ..... ft., Dia ..... in. to ..... ft.  
 Casing height above land surface 12 in., weight ..... lbs./ft. Wall thickness or gauge No. SDR 26  
 TYPE OF SCREEN OR PERFORATION MATERIAL:  PVC 10 Asbestos-cement  
 1 Steel 3 Stainless steel 5 Fiberglass 8 RMP (SR) 11 Other (specify) .....  
 2 Brass 4 Galvanized steel 6 Concrete tile 9 ABS 12 None used (open hole)  
 SCREEN OR PERFORATION OPENINGS ARE: 5 Gauzed wrapped  Saw cut 11 None (open hole)  
 1 Continuous slot 3 Mill slot 6 Wire wrapped 9 Drilled holes  
 2 Louvered shutter 4 Key punched 7 Torch cut 10 Other (specify) .....  
 SCREEN-PERFORATED INTERVALS: From 93 ft. to 113 ft., From ..... ft. to ..... ft.  
 From ..... ft. to ..... ft., From ..... ft. to ..... ft.  
 GRAVEL PACK INTERVALS: From 25 ft. to 80 ft., From ..... ft. to ..... ft.  
 From 90 ft. to 113 ft., From ..... ft. to ..... ft.

6 GROUT MATERIAL: 1 Neat cement 2 Cement grout  Bentonite 4 Other .....  
 Grout intervals: From 4 ft. to 25 ft., From 80 ft. to 90 ft., From ..... ft. to ..... ft.  
 What is the nearest source of possible contamination:  
 1 Septic tank 4 Lateral lines 7 Pit privy 10 Livestock pens  14 Abandoned water well  
 2 Sewer lines 5 Cess pool 8 Sewage lagoon 11 Fuel storage 15 Oil well/Gas well  
 3 Watertight sewer lines 6 Seepage pit 9 Feedyard 12 Fertilizer storage 16 Other (specify below)  
 13 Insecticide storage  
 Direction from well? Southeast How many feet? 60

FROM	TO	LITHOLOGIC LOG	FROM	TO	LITHOLOGIC LOG
0	2	Topsoil			
2	12	Brown clay			
12	23	Sand			
23	30	Tan clay			
30	64	Sand & gravel			
64	75	Tan clay			
75	81	Gravel			
81	88	Tan clay			
88	103	Gravel			
103	108	Tan clay			
108	110	Gravel			
110	113	Tan clay			

7 CONTRACTOR'S OR LANDOWNER'S CERTIFICATION: This water well was (1) constructed, (2) reconstructed, or (3) plugged under my jurisdiction and was completed on (mo/day/year) 10/3/88 and this record is true to the best of my knowledge and belief. Kansas Water Well Contractor's License No. 224. This Water Well Record was completed on (mo/day/yr) 1/9/89 under the business name of Carl Hayse Water Well Service by (signature) Carl Hayse

INSTRUCTIONS: Use typewriter or ball point pen. PLEASE PRESS FIRMLY and PRINT clearly. Please fill in blanks, underline or circle the correct answers. Send top three copies to Kansas Department of Health and Environment, Bureau of Water Protection, Topeka, Kansas 66620-7320, Telephone: 913-862-9360. Send one to WATER WELL OWNER and retain one for your records.

OFFICE USE ONLY T R E W SEC. 1/4 1/4 1/4