√ 11

USE TYPEWRITER OR BALL POINT PEN-PRESS FIRMLY, PRINT CLEARLY.

WATER WELL RECORD
KSA 82a-1201-1215

Kansas Department of Health and Environment-Division of Environment
(Water well Contractors)
Topeka, Kansas 66620

X Location of well:	County: Edwards	Fraction: C/SW (1/4 1/4 1/4)	Section number: 9	Township number: T 26 S	Range number: R 17 E/W

2. Distance and direction from nearest town or city: Kellsburg
Street address of well location if in city: 1½ south 3/4 West

3. Owner of well: Jake Roenbanger
R.R. or street:
City, state, zip code: Lewis, Ks.

X Locate with "X" in section below:

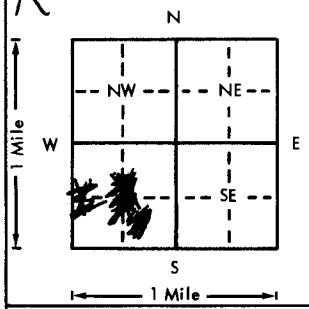

Sketch map:

6. Bore hole dia. 29 in. Completion date 1-30-76
Well depth 151 ft.

7. __ Cable tool ✓ Rotary __ Driven __ Dug
__ Hollow rod __ Jetted __ Bored __ Reverse rotary

8. Use: __ Domestic __ Public supply __ Industry
✓ Irrigation __ Air conditioning __ Stock
__ Lawn __ Oil field water __ Other

9. Casing: Material Steel ✓ Height: Above or below 18 in.
Threaded ___ Welded ✓ Surface
RMP ___ PVC ___ Weight ___ lbs./ft.
Dia. 16 in. to 151 ft. depth Wall Thickness: inches or
Dia. ___ in. to ___ ft. depth gage No. 7

5. Type and color of material	From	To
Sandy Top Soil	0	2
Brown Sandy Clay	2	7
Sand & Gravel	7	18
Brown Clay	18	25
Fine Sand & Brown & White Clay	25	33
Sand & Gravel	33	38
Hard Black Rock	38	41
Sand & Gravel clean coarse loose	41	67
Brown & white Clay	67	80
Sand & Gravel	80	87
Brown & white Clay	87	103
Sand & Gravel clean coarse loose	103	151
Brown & Gray Clay	151	155
(Use a second sheet if needed)		

10. Screen: Manufacturer's name Deeirs
Type steel Dia. 16
Slot/gauze 3/16 Length 48
Set between 103 ft. and 151 ft.
ft. and ft.
Gravel pack? ✓ Size range of material 1/2 3/4 3/8

11. Static water level: mo./day/yr.
16 ft. below land surface Date 11-7-75

12. Pumping level below land surfaces:
18 ft. after 1 hrs. pumping 1000 g.p.m.
ft. after hrs. pumping g.p.m.
Estimated maximum yield 1200+ g.p.m.

13. Water sample submitted: mo./day/yr.
✓ Yes ___ No Date 11-21-75

14. Well head completion:
___ Pitless adapter ___ Inches above grade

15. Well grouted? ✓
With: ___ Neat cement ___ Bentonite ✓ Concrete
Depth: From 0 ft. to 10 ft.

16. Nearest source of possible contamination:
ft. Direction NW Type Correl
Well disinfected upon completion? ___ Yes ___ No

17. Pump: ___ Not installed
Manufacturer's name B W & R
Model number 5-BHC-12 HP 80 Volts
Length of drop pipe 80 ft. capacity 800 g.p.m.
Type:
___ Submersible ✓ Turbine
___ Jet ___ Reciprocating
___ Centrifugal ___ Other

18. Elevation: 2138'
Topography:
___ Hill
✓ Slope
___ Upland
___ Valley

19. Remarks:

20. Water well contractor's certification:
This well was drilled under my jurisdiction and this report is true to the best of my knowledge and belief.
Business name Rosencrantz-Bemis License No. 134
Address Great Bend Ks.
Signed Freda Dodson Date 9/30/76
Authorized representative

T 26 R 17 Sec 9 1/4 1/4 1/4 CSW

Forward the white, blue and pink copies to the Department of Health and Environment

Form WWC-5

MI-1023