


1 LOCATION OF WATER WELL: County: Edwards Fraction: NW 1/4 NW 1/4 NW 1/4 Section Number: 10 Township Number: T 26 S Range Number: R 17 E/W

Distance and direction from nearest town or city street address of well if located within city?
1/2 S. Fellsburg Kansas

2 WATER WELL OWNER: Lloyd Miller
RR#, St. Address, Box #: Fellsburg Kans
City, State, ZIP Code: Fellsburg Kans
Board of Agriculture, Division of Water Resources
Application Number:

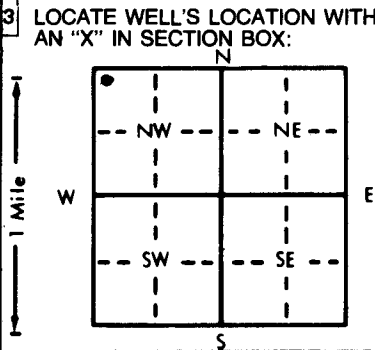

4 DEPTH OF COMPLETED WELL: 80 ft. ELEVATION: 5-27-83
Depth(s) Groundwater Encountered: 1. 31 ft. 2. 31 ft. 3. 31 ft.
WELL'S STATIC WATER LEVEL: 31 ft. below land surface measured on mo/day/yr 5-27-83
Pump test data: Well water was 31 ft. after 1 hours pumping 10 gpm
Est. Yield 25 gpm. Well water was 31 ft. after 1 hours pumping 10 gpm
Bore Hole Diameter: 8 3/4 in. to 80 ft., and 80 in. to 80 ft.
WELL WATER TO BE USED AS:
5 Public water supply 8 Air conditioning 11 Injection well
1 Domestic 3 Feedlot 6 Oil field water supply 9 Dewatering 12 Other (Specify below)
2 Irrigation 4 Industrial 7 Lawn and garden only 10 Observation well
Was a chemical/bacteriological sample submitted to Department? Yes X No X; If yes, mo/day/yr sample was submitted
Water Well Disinfected? Yes X No X

5 TYPE OF BLANK CASING USED:
1 Steel 3 RMP (SR) 5 Wrought iron 8 Concrete tile CASING JOINTS: Glued X Clamped X
2 PVC 4 ABS 6 Asbestos-Cement 9 Other (specify below) Welded X
Casing height above land surface: 12 in., weight 12 lbs./ft. Wall thickness or gauge No. SDR-26
TYPE OF SCREEN OR PERFORATION MATERIAL:
1 Steel 3 Stainless steel 5 Fiberglass 7 PVC 10 Asbestos-cement
2 Brass 4 Galvanized steel 6 Concrete tile 8 RMP (SR) 11 Other (specify)
SCREEN OR PERFORATION OPENINGS ARE:
1 Continuous slot 3 Mill slot 5 Gauzed wrapped 8 Saw cut 11 None (open hole)
2 Louvered shutter 4 Key punched 6 Wire wrapped 9 Drilled holes
3 Torch cut 10 Other (specify)
SCREEN-PERFORATED INTERVALS: From 60 ft. to 80 ft. From 60 ft. to 80 ft. From 60 ft. to 80 ft. From 60 ft. to 80 ft.
GRAVEL PACK INTERVALS: From 45 ft. to 80 ft. From 45 ft. to 80 ft. From 45 ft. to 80 ft. From 45 ft. to 80 ft.

6 GROUT MATERIAL: 1 Neat cement 2 Cement grout 3 Bentonite 4 Other
Grout intervals: From 7 ft. to 14 ft. From 7 ft. to 14 ft. From 7 ft. to 14 ft. From 7 ft. to 14 ft.
What is the nearest source of possible contamination:
1 Septic tank 4 Lateral lines 7 Pit privy 10 Livestock pens 14 Abandoned water well
2 Sewer lines 5 Cess pool 8 Sewage lagoon 11 Fuel storage 15 Oil well/Gas well
3 Watertight sewer lines 6 Seepage pit 9 Feedyard 12 Fertilizer storage 16 Other (specify below)
Direction from well? NE How many feet? 80

FROM	TO	LITHOLOGIC LOG	FROM	TO	LITHOLOGIC LOG
0	1	Top Soil			
1	5	Silt & Sand			
5	16	Clay			
16	28	Sand			
28	32	Clay			
32	36	Sand			
36	74	Sand & Gravel			
74	80	Clay			

7 CONTRACTOR'S OR LANDOWNER'S CERTIFICATION: This water well was (1) constructed, (2) reconstructed, or (3) plugged under my jurisdiction and was completed on (mo/day/year) 5-27-83 and this record is true to the best of my knowledge and belief. Kansas Water Well Contractor's License No. 224 This Water Well Record was completed on (mo/day/yr) 7-29-83 under the business name of Carl Hayse Water Well Sew by (signature) Carl Hayse
INSTRUCTIONS: Use typewriter or ball point pen. PLEASE PRESS FIRMLY and PRINT clearly. Please fill in blanks, underline or circle the correct answers. Send top three copies to Kansas Department of Health and Environment, Division of Environment, Environmental Geology Section, Topeka, KS 66620. Send one to WATER WELL OWNER and retain one for your records.

OFFICE USE ONLY
T
R
17
SEC.
10
NW 1/4
NW 1/4
NW 1/4