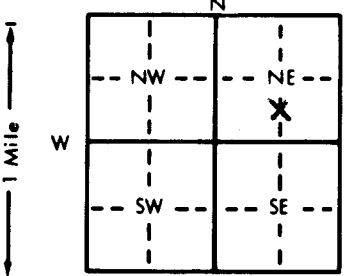


1 LOCATION OF WATER WELL: Fraction Section Number Township Number Range Number
 County: Edwards Near Q⁴ S^{1/2} 1/4 NE 1/4 12 T 26 S R 17 EW

Distance and direction from nearest town or city street address of well if located within city?
2 1/2 east 1 1/8 south of Fellsburg

2 WATER WELL OWNER: Mr. Welton Parker
 RR#, St. Address, Box #: Rt. 1
 City, State, ZIP Code: Lewis, Ks. 67552
 Board of Agriculture, Division of Water Resources
 Application Number: 34,950 & 34,998

3 LOCATE WELL'S LOCATION WITH AN "X" IN SECTION BOX:

 4 DEPTH OF COMPLETED WELL: 194 ft. ELEVATION:
 Depth(s) Groundwater Encountered 1. 24 ft. 2. _____ ft. 3. _____ ft.
 WELL'S STATIC WATER LEVEL 39 ft. below land surface measured on mo/day/yr 3-12-81
 Pump test data: Well water was 50 ft. after 1 hours pumping 1200 gpm
 Est. Yield 1400 gpm: Well water was 53 ft. after 1 1/2 hours pumping 1400 gpm
 Bore Hole Diameter: 29 in. to 194 ft., and _____ in. to _____ ft.
 WELL WATER TO BE USED AS:
 5 Public water supply 8 Air conditioning 11 Injection well
 1 Domestic 3 Feedlot 6 Oil field water supply 9 Dewatering 12 Other (Specify below)
2 Irrigation 4 Industrial 7 Lawn and garden only 10 Observation well
 Was a chemical/bacteriological sample submitted to Department? Yes _____ No X _____; If yes, mo/day/yr sample was submitted _____
 Water Well Disinfected? Yes HTH No _____

5 TYPE OF BLANK CASING USED:
 1 Steel 3 RMP (SR) 5 Wrought iron 8 Concrete tile CASING JOINTS: Glued _____ Clamped _____
 2 PVC 4 ABS 6 Asbestos-Cement 9 Other (specify below) Welded X _____
 7 Fiberglass _____ Threaded _____
 Blank casing diameter 16 in. to 154 ft., Dia _____ in. to _____ ft., Dia _____ in. to _____ ft.
 Casing height above land surface 18 in., weight _____ lbs./ft. Wall thickness or gauge No. 7
 TYPE OF SCREEN OR PERFORATION MATERIAL:
 1 Steel 3 Stainless steel 5 Fiberglass 8 RMP (SR) 10 Asbestos-cement
 2 Brass 4 Galvanized steel 6 Concrete tile 9 ABS 11 Other (specify) _____
 12 None used (open hole) _____
 SCREEN OR PERFORATION OPENINGS ARE:
 1 Continuous slot 3 Mill slot 5 Gauzed wrapped 8 Saw cut 11 None (open hole)
 2 Louvered shutter 4 Key punched 6 Wire wrapped 9 Drilled holes
 7 Torch cut 10 Other (specify) _____
 SCREEN-PERFORATED INTERVALS: From 154 ft. to 194 ft., From _____ ft. to _____ ft.
 From _____ ft. to _____ ft., From _____ ft. to _____ ft.
 GRAVEL PACK INTERVALS: From 10 ft. to 194 ft., From _____ ft. to _____ ft.
 From _____ ft. to _____ ft., From _____ ft. to _____ ft.

6 GROUT MATERIAL: 1 Neat cement 2 Cement grout 3 Bentonite 4 Other _____
 Grout Intervals: From 0 ft. to 10 ft., From _____ ft. to _____ ft., From _____ ft. to _____ ft.
 What is the nearest source of possible contamination:
 1 Septic tank 4 Lateral lines 7 Pit privy 10 Livestock pens 14 Abandoned water well
 2 Sewer lines 5 Cess pool 8 Sewage lagoon 11 Fuel storage 15 Oil well/Gas well
 3 Watertight sewer lines 6 Seepage pit 9 Feedyard 12 Fertilizer storage 16 Other (specify below)
 13 Insecticide storage NONE
 Direction from well? _____ How many feet? _____

FROM	TO	LITHOLOGIC LOG	FROM	TO	LITHOLOGIC LOG
0	5	Sandy clay			
5	15	Sand and gravel			
15	25	Gravel mixed with clay			
25	45	Sand and gravel			
45	55	Gravel mixed with clay			
55	65	Clay with gravel			
65	100	Gravel w/fine pieces of light brown clay			
100	114	Sand and gravel			
114	116	White clay			
116	125	Sand and gravel mixed with clay			
125	150	Sand and gravel			
150	155	Sand			
155	194	Sand and gravel			

7 CONTRACTOR'S OR LANDOWNER'S CERTIFICATION: This water well was (1) constructed, (2) reconstructed, or (3) plugged under my jurisdiction and was completed on (mo/day/year) 6-12-82 and this record is true to the best of my knowledge and belief. Kansas Water Well Contractor's License No. 134 This Water Well Record was completed on (mo/day/yr) 7-9-82 under the business name of Rosencrantz-Bemis Ent. by (signature) Hora Dodson
 INSTRUCTIONS: Use typewriter or ball point pen, PLEASE PRESS FIRMLY and PRINT clearly. Please fill in blanks, underline or circle the correct answers. Send top three copies to Kansas Department of Health and Environment, Division of Environment, Environmental Geology Section, Topeka, KS 66620. Send one to WATER WELL OWNER and retain one for your records.

OFFICE USE ONLY
T
R
17
EMD
SEC. 12
C
1/4
S
1/4
ME 1/4