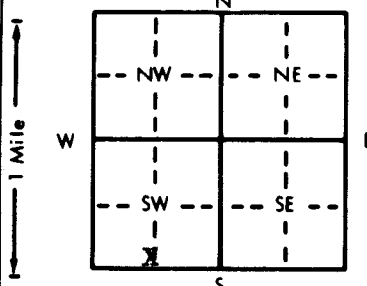


1 LOCATION OF WATER WELL: Fraction on 1/4 mile Line, 300' Section Number Township Number Range Number
 County: Edwards 1/4 No. of Road SW 1/4 14 T 26 S R 17 EW

Distance and direction from nearest town or city street address of well if located within city?
 Approx. 2 1/2 miles south of Fellsburg and 1/4 mile east.

2 WATER WELL OWNER: J. D. Carroll
 RR#, St. Address, Box #: 1718 W. Blanchard Board of Agriculture, Division of Water Resources
 City, State, ZIP Code: So. Hutchinson, KS 67505 Application Number: not available

3 LOCATE WELL'S LOCATION WITH AN "X" IN SECTION BOX:


4 DEPTH OF COMPLETED WELL: 100 ft. ELEVATION: unknown
 Depth(s) Groundwater Encountered 1. 21' ft. 2. ft. 3. ft.
 WELL'S STATIC WATER LEVEL: 21 ft. below land surface measured on mo/day/yr 4-13-84
 Pump test data: Well water was Not ck'd ft. after hours pumping gpm
 Est. Yield 850 gpm: Well water was ft. after hours pumping gpm
 Bore Hole Diameter 24 in. to 100 ft. and in. to ft.
 WELL WATER TO BE USED AS:
 5 Public water supply 8 Air conditioning 11 Injection well
 1 Domestic 3 Feedlot 6 Oil field water supply 9 Dewatering 12 Other (Specify below)
 2 Irrigation 4 Industrial 7 Lawn and garden only 10 Observation well
 Was a chemical/bacteriological sample submitted to Department? Yes No X; If yes, mo/day/yr sample was submitted
 Water Well Disinfected? Yes NO XX

5 TYPE OF BLANK CASING USED:
 1 Steel 3 RMP (SR) 5 Wrought iron 8 Concrete tile CASING JOINTS: Glued Clamped
 2 PVC 4 ABS 6 Asbestos-Cement 9 Other (specify below) Welded XXX
 7 Fiberglass Threaded
 Blank casing diameter 16 in. to 60 ft., Dia in. to ft., Dia in. to ft.
 Casing height above land surface 12 in., weight 36.87 lbs./ft. Wall thickness or gauge No. 219
 TYPE OF SCREEN OR PERFORATION MATERIAL:
 1 Steel 3 Stainless steel 5 Fiberglass 8 RMP (SR) 10 Asbestos-cement
 2 Brass 4 Galvanized steel 6 Concrete tile 9 ABS 11 Other (specify)
 12 None used (open hole)
 SCREEN OR PERFORATION OPENINGS ARE:
 1 Continuous slot 3 Mill slot 5 Gauzed wrapped 8 Saw cut 11 None (open hole)
 2 Louvered shutter 4 Key punched 6 Wire wrapped 9 Drilled holes
 7 Torch cut 10 Other (specify) DOERR BRIDGE SLOT
 SCREEN-PERFORATED INTERVALS: From X 60 ft. to 100 ft., From ft. to ft.
 From ft. to ft., From ft. to ft.
 GRAVEL PACK INTERVALS: From 10 ft. to 100 ft., From ft. to ft.
 From ft. to ft., From ft. to ft.

6 GROUT MATERIAL: 1 Neat cement 2 Cement grout 3 Bentonite 4 Other
 Grout Intervals: From 0 ft. to 10 ft., From ft. to ft., From ft. to ft.
 What is the nearest source of possible contamination:
 1 Septic tank 4 Lateral lines 7 Pit privy 10 Livestock pens 14 Abandoned water well
 2 Sewer lines 5 Cess pool 8 Sewage lagoon 11 Fuel storage 15 Oil well/Gas well
 3 Watertight sewer lines 6 Seepage pit 9 Feedyard 12 Fertilizer storage 16 Other (specify below)
 13 Insecticide storage FIELD

Direction from well? all How many feet?

FROM	TO	LITHOLOGIC LOG	FROM	TO	LITHOLOGIC LOG
0	6	Fine sand topsoil & brown sandy clay			
6	15	Fine sand			
15	55	Sand & gravel, med. to coarse, clean			
55	70	Sand & gravel, fine to med. w/a couple thin clay streaks between 55' & 60'			
70	80	Sand & gravel, med. to coarse w/a couple thin clay streaks between 70' -75'			
80	81	Yellow clay			
81	99	Sand & gravel, med. to fine			
99	100	Yellow clay			

7 CONTRACTOR'S OR LANDOWNER'S CERTIFICATION: This water well was (1) constructed, (2) reconstructed, or (3) plugged under my jurisdiction and was completed on (mo/day/year) 4-13-84 and this record is true to the best of my knowledge and belief. Kansas Water Well Contractor's License No. 185 This Water Well Record was completed on (mo/day/yr) 4/19/84 under the business name of CLARKE WELL & EQ., INC. by (signature)

INSTRUCTIONS: Use typewriter or ball point pen, PLEASE PRESS FIRMLY and PRINT clearly. Please fill in blanks, underline or circle the correct answers. Send top three copies to Kansas Department of Health and Environment, Division of Environment, Environmental Geology Section, Topeka, KS 66620. Send one to WATER WELL OWNER and retain one for your records.

OFFICE USE ONLY
T
R
EW
SEC