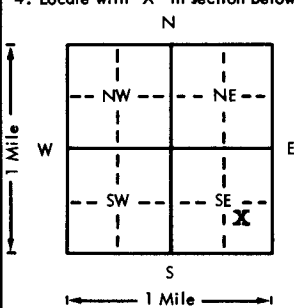


USE TYPEWRITER OR BALL  
POINT PEN-PRESS FIRMLY,  
PRINT CLEARLY.

WATER WELL RECORD  
KSA 82a-1201-1215

Kansas Department of Health and  
Environment-Division of Environment  
(Water well Contractors)  
Topeka, Kansas 66620

1. Location of well:		County <b>Edwards</b>	Fraction <b>C of E<sub>1</sub> 1/4 se 1/4</b>	Section number <b>28</b>	Township number <b>T 26 S</b>	Range number <b>R 17W E/W</b>
2. Distance and direction from nearest town or city: Street address of well location if in city: <del>6500 E. 1st St.</del> <b>9.5 mi. S of Jellison</b>			3. Owner of well: <b>Pickrell Drilling Co.</b> R.R. or street: <b>Litwin Bldg. Suite 205</b> City, state, zip code: <b>Wichita, Ka.</b>			
4. Locate with "X" in section below:  Sketch map: <i>Jellison road.</i>			6. Bore hole dia. <u>9</u> in. Completion date <u>7-25-76</u> Well depth <u>84</u> ft.			
5. Type and color of material			7. <input type="checkbox"/> Cable tool <input checked="" type="checkbox"/> Rotary <input type="checkbox"/> Driven <input type="checkbox"/> Dug <input type="checkbox"/> Hollow rod <input type="checkbox"/> Jetted <input type="checkbox"/> Bored <input type="checkbox"/> Reverse rotary			
			8. Use: <input type="checkbox"/> Domestic <input type="checkbox"/> Public supply <input checked="" type="checkbox"/> Industry <input type="checkbox"/> Irrigation <input type="checkbox"/> Air conditioning <input type="checkbox"/> Stock <input type="checkbox"/> Lawn <input type="checkbox"/> Oil field water <input type="checkbox"/> Other			
			Casing: Material <input type="checkbox"/> Height: Above or <input checked="" type="checkbox"/> Below Threaded <input type="checkbox"/> Welded <input checked="" type="checkbox"/> Surface <u>18</u> in. RMP <input type="checkbox"/> PVC <input checked="" type="checkbox"/> Weight <u>12.37</u> lbs./ft. Dia. <u>4</u> in. to <u>84</u> ft. depth <input checked="" type="checkbox"/> Thickness: inches or Dia. <u>4</u> in. to <u>84</u> ft. depth <input type="checkbox"/> No. <u>1237</u>			
			10. Screen: Manufacturer's name <u>R &amp; E</u> Type <u>pvc</u> Dia. <u>4</u> Slot/gauze <u>1/16</u> Length <u>20</u> Set between <u>64</u> ft. and <u>84</u> ft. Gravel pack? <u>yes</u> Size range of material <u>3/4-3/8-1/2</u>			
			X. Static water level: <u>18</u> ft. below land surface Date <u>7-25-76</u> mo./day/yr.			
			12. Pumping level below land surfaces: ____ ft. after ____ hrs. pumping <u>NA</u> g.p.m. ____ ft. after ____ hrs. pumping ____ g.p.m. Estimated maximum yield ____ g.p.m.			
			13. Water sample submitted: ____ mo./day/yr. Yes <input checked="" type="checkbox"/> No <input type="checkbox"/> Date ____			
			14. Well head completion: ____ Pitless adapter ____ inches above grade			
			15. Well grouted? ____ With: ____ Neat cement ____ Bentonite <input checked="" type="checkbox"/> Concrete Depth: From <u>0</u> ft. to <u>10</u> ft.			
			16. Nearest source of possible contamination: ft. <u>150</u> Direction <u>SE</u> Type <u>oil well</u> Well disinfected upon completion? ____ Yes ____ No			
(Use a second sheet if needed)			17. Pump: <input checked="" type="checkbox"/> Not installed Manufacturer's name ____ Model number ____ HP ____ Volts ____ Length of drop pipe ____ ft. capacity ____ g.p.m. Type: <input type="checkbox"/> Submersible <input type="checkbox"/> Turbine <input type="checkbox"/> Jet <input type="checkbox"/> Reciprocating <input type="checkbox"/> Centrifugal <input type="checkbox"/> Other			
			20. Water well contractor's certification: This well was drilled under my jurisdiction and this report is true to the best of my knowledge and belief. <b>Rosencrantz-Bemis</b> Business name <u>Great Bend, Ka.</u> License No. <u>134</u> Address <u>9/29/76</u> Signed <u>Fredia Dodson</u> Date <u>9/29/76</u> Authorized representative			
			18. Elevation:			
			19. Remarks:			
			Topography: <input type="checkbox"/> Hill <input type="checkbox"/> Slope <input checked="" type="checkbox"/> Upland <input type="checkbox"/> Valley			

Forward the white, blue and pink copies to the Department of Health and Environment

Form WWC-5