


WATER WELL RECORD Form WWC-5 KSA 82a-1212

1 LOCATION OF WATER WELL: Fraction Section Number Township Number Range Number  
 COUNTY: 024 EDWARDS NW 1/4 NW 1/4 NW 1/4 21 T 26 S R 18 W

Distance and direction from nearest town or city street address of well if located within city?  
 6 E. 9 S. OF KINSLEY, KS

2 WATER WELL OWNER: KENNY UNRUH 325 Board of Agriculture, Division of Water Resources  
 RR#, St. Address, Box #: R.R. 2 BOX 32  
 City, State, ZIP code: LEWIS, KS 67552- Application Number:

3 LOCATE WELL'S LOCATION WITH AN "X" IN SECTION BOX:

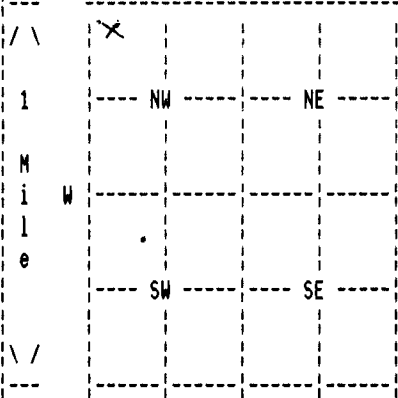

4 DEPTH OF COMPLETED WELL 30 ELEVATION: 0  
 Depth(s) Groundwater Encountered 1. 0 ft. 2. 0 ft. 3. 0 ft.

WELL'S STATIC WATER LEVEL 0 ft. below land surface measured on mo/day/yr  
 Pump test data: Well water was 0 ft. after 0 hours pumping 0 gpm

Estimated Yield 0 gpm: Well water was 0 ft. after 0 hours pumping 0 gpm

Bore Hole Diameter 4 in. to 30 ft., and in. to 0 ft.

WELL WATER TO BE USED AS: 01 DOMESTIC

Was a chemical/bacteriological sample submitted to department? No ;  
 If yes, mo/day/yr sample was submitted Water well disinfected? Yes

5 TYPE OF BLANK CASING USED: 01 STEEL CASING JOINTS: CLAMPED  
 Blank casing diameter 4 in. to 30 ft., Dia in. to 0 ft., Dia in. to 0 ft.  
 Casing height above land surface -144 in., weight 0 lbs./ft. Wall thickness or gauge No. 20  
 TYPE OF SCREEN OR PERFORATION MATERIAL: NONE USED  
 SCREEN OR PERFORATION OPENINGS ARE: 11 NONE (OPEN)

SCREEN PERFORATED INTERVALS: From 0 ft. to 0 ft., From 0 ft. to 0 ft.  
 From 0 ft. to 0 ft., From 0 ft. to 0 ft.  
 GRAVEL PACK INTERVALS: From 0 ft. to 0 ft., From 0 ft. to 0 ft.  
 From 0 ft. to 0 ft., From 0 ft. to 0 ft.

6 GROUT MATERIAL 03 BENTONITE  
 Grout Intervals: From 0 ft. to 0 ft., From 0 ft. to 0 ft., From 0 ft. to 0 ft.  
 What is the nearest source of possible contamination: 01 SEPTIC TANK  
 Direction from well? W How many feet? 75

FROM	TO	LITHOLOGIC LOG	FROM	TO	PLUGGING INTERVALS
			12	30	HOLEPLUG
			0	12	CLAY
			0	0	
			0	0	
			0	0	
			0	0	
			0	0	
			0	0	
			0	0	

7 CONTRACTOR'S OR LANDOWNER'S CERTIFICATION: This water well was Plugged under my jurisdiction and was completed on (mo/day/year) 6 /17/95 and this record is true to the best of my knowledge and belief. Kansas Water Well Contractor's License No. 224 This Water Well Record was completed on (mo/day/yr) 06/30/95 under the business name of CARL HAYSE WATER WELL SVC by (signature) Carl Hayse