


1 LOCATION OF WATER WELL: County: Edwards Fraction: SE 1/4 NE 1/4 NW 1/4 Section Number: 25 Township Number: T 26 S Range Number: R 18W EW

Distance and direction from nearest town or city street address of well if located within city? 3 1/2 S, 1 E of Centerview, Kansas

2 WATER WELL OWNER: Richard Meyer RR#, St. Address, Box #: Route 1 City, State, ZIP Code: St. John, Kansas 67576 Board of Agriculture, Division of Water Resources Application Number:

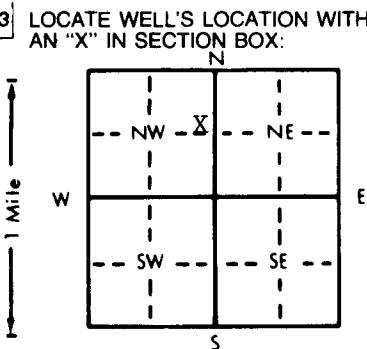

3 LOCATE WELL'S LOCATION WITH AN 'X' IN SECTION BOX: 4 DEPTH OF COMPLETED WELL: 88 ft. ELEVATION: Unknown. WELL'S STATIC WATER LEVEL: 35 ft. below land surface measured on 12/8/95. Pump test data: Well water was 40 gpm. Bore Hole Diameter: 7 7/8 in. to 88 ft. WELL WATER TO BE USED AS: 1 Domestic, 2 Irrigation, 3 Feedlot, 4 Industrial, 5 Public water supply, 6 Oil field water supply, 7 Lawn and garden only, 8 Air conditioning, 9 Dewatering, 10 Monitoring well, 11 Injection well, 12 Other (Specify below). Was a chemical/bacteriological sample submitted? No. Water Well Disinfected? Yes No

5 TYPE OF BLANK CASING USED: 1 Steel, 2 PVC, 3 RMP (SR), 4 ABS, 5 Wrought iron, 6 Asbestos-Cement, 7 Fiberglass, 8 Concrete tile, 9 Other (specify below), 10 Monitoring well, CASING JOINTS: Glued, Welded, Threaded. Blank casing diameter: 5 in. to 68 ft. Dia. Casing height above land surface: 12 in., weight: 2.8 lbs./ft. Wall thickness or gauge No. Sch. 40. TYPE OF SCREEN OR PERFORATION MATERIAL: 1 Steel, 2 Brass, 3 Stainless steel, 4 Galvanized steel, 5 Fiberglass, 6 Concrete tile, 7 PVC, 8 RMP (SR), 9 ABS, 10 Asbestos-cement, 11 Other (specify), 12 None used (open hole). SCREEN OR PERFORATION OPENINGS ARE: 1 Continuous slot, 2 Louvered shutter, 3 Mill slot, 4 Key punched, 5 Gauzed wrapped, 6 Wire wrapped, 7 Torch cut, 8 Saw cut, 9 Drilled holes, 10 Other (specify), 11 None (open hole). SCREEN-PERFORATED INTERVALS: From 0 ft. to 20 ft. GRAVEL PACK INTERVALS: From 20 ft. to 88 ft.

6 GROUT MATERIAL: 1 Neat cement, 2 Cement grout, 3 Bentonite, 4 Other. Grout Intervals: From 0 ft. to 20 ft. What is the nearest source of possible contamination: 1 Septic tank, 2 Sewer lines, 3 Watertight sewer lines, 4 Lateral lines, 5 Cess pool, 6 Seepage pit, 7 Pit privy, 8 Sewage lagoon, 9 Feedyard, 10 Livestock pens, 11 Fuel storage, 12 Fertilizer storage, 13 Insecticide storage, 14 Abandoned water well, 15 Oil well/Gas well, 16 Other (specify below). In field.

Direction from well? How many feet? Table with columns: FROM, TO, LITHOLOGIC LOG, FROM, TO, PLUGGING INTERVALS. Row 1: 0 to 45, Top soil and clay. Row 2: 45 to 88, Sand and gravel.

7 CONTRACTOR'S OR LANDOWNER'S CERTIFICATION: This water well was (1) constructed, (2) reconstructed, or (3) plugged under my jurisdiction and was completed on (mo/day/year) 12/8/95 and this record is true to the best of my knowledge and belief. Kansas Water Well Contractor's License No. 186 This Water Well Record was completed on (mo/day/yr) 12/12/95 under the business name of Kelly's Water Well Service, Inc. by (signature) Alvin Load

OFFICE USE ONLY T R EW SEC 1/4 1/4 1/4