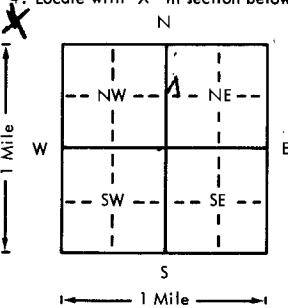


USE TYPEWRITER OR BALL
POINT PEN-PRESS FIRMLY,
PRINT CLEARLY.

WATER WELL RECORD
KSA 82a-1201-1215

Kansas Department of Health and
Environment-Division of Environment
(Water well Contractors)
Topeka, Kansas 66620

1. Location of well:		County Edwards	Fraction sw 1/4 ne 1/4	Section number 4-	Township number T 26 S R 18 E	Range number 18
2. Distance and direction from nearest town or city: 7 1/2 - 1 3/4 west of Lewis, Ks. Street address of well location if in city: 7 1/2 - S 2 - W of Lewis Ks.			3. Owner of well: Norman Nelson R.R. or street: Long Island, Ks. 67647 City, state, zip code:			
4. Locate with "X" in section below: 			Sketch map:		6. Bore hole dia. 29 in. Completion date Well depth 79 1/2 ft. 5-5-76	
5. Type and color of material			From	To	7. <input type="checkbox"/> Cable tool <input checked="" type="checkbox"/> Rotary <input type="checkbox"/> Driven <input type="checkbox"/> Dug <input type="checkbox"/> Hollow rod <input type="checkbox"/> Jetted <input type="checkbox"/> Bored <input type="checkbox"/> Reverse rotary	
Top soil			0	2	8. Use: <input type="checkbox"/> Domestic <input type="checkbox"/> Public supply <input type="checkbox"/> Industry <input checked="" type="checkbox"/> Irrigation <input type="checkbox"/> Air conditioning <input type="checkbox"/> Stock <input type="checkbox"/> Lawn <input type="checkbox"/> Oil field water <input type="checkbox"/> Other	
Brown clay			2	6	9. Casing: Material steel Height: Above or below Threaded <input type="checkbox"/> Welded <input checked="" type="checkbox"/> Surface 12 in. RMP <input type="checkbox"/> PVC <input type="checkbox"/> Weight <input type="checkbox"/> lbs./ft. Dia. 16 in. to 79 1/2 ft. depth Wall Thickness: inches or Dia. <input type="checkbox"/> in. to <input type="checkbox"/> ft. depth gage No. 7	
Green clay			6	10	10. Screen: Manufacturer's name Doerra Type steel Dia. 16 Slot/groove 3/16 Length 20 Set between 59 1/2 ft. and 79 1/2 ft. ft. and <input type="checkbox"/> ft.	
Sandy brown clay			10	21	Gravel pack? <input checked="" type="checkbox"/> Size range of material 3/4-3/8-1/2	
Sand and gravel			21	38	11. Static water level: <input type="checkbox"/> mo./day/yr. 2310-48-75 Date 10-28-75	
Sand and gravel w/ clay streaks			38	60	12. Pumping level below land surfaces: 54 ft. after 1 hrs. pumping 600 g.p.m. <input type="checkbox"/> ft. after <input type="checkbox"/> hrs. pumping <input type="checkbox"/> g.p.m. Estimated maximum yield 650 g.p.m.	
Sand and gravel			60	83	13. Water sample submitted: <input type="checkbox"/> mo./day/yr. <input checked="" type="checkbox"/> Yes <input type="checkbox"/> No Date 10-28-75	
Brown clay			83	130	14. Well head completion: <input type="checkbox"/> Pitless adapter <input type="checkbox"/> Inches above grade	
					15. Well grouted? <input checked="" type="checkbox"/> With: <input checked="" type="checkbox"/> Neat cement <input type="checkbox"/> Bentonite <input type="checkbox"/> Concrete Depth: From 0 ft. to 10 ft.	
					16. Nearest source of possible contamination: ft. 1 1/2 miles east Type septic Well disinfected upon completion? hth Yes <input type="checkbox"/> No <input type="checkbox"/>	
					17. Pump: Manufacturer's name W.L.B. Model number 2-10chc HP 60 Volts <input type="checkbox"/> Length of drop pipe 70 ft. capacity 600 g.p.m. Type: <input type="checkbox"/> Submersible <input checked="" type="checkbox"/> Turbine <input type="checkbox"/> Jet <input type="checkbox"/> Reciprocating <input type="checkbox"/> Centrifugal <input type="checkbox"/> Other	
18. Elevation:			19. Remarks:		20. Water well contractor's certification: This well was drilled under my jurisdiction and this report is true to the best of my knowledge and belief. Wossencrantz-Bemis 134 Business name License No. Address Great Bend, Ks. 67530 Signed S. K. LOOSE Date 6-19-79 Authorized representative	

Forward the white, blue and pink copies to the Department of Health and Environment

Form WWC-5