USE TYPEWRITER OR BALL POINT PEN-PRESS FIRMLY, PRINT CLEARLY.

WATER WELL RECORD
KSA 82a-1201-1215

Kansas Department of Health and Environment-Division of Environment
(Water well Contractors)
Topeka, Kansas 66620

1. Location of well:	County	Fraction	Section number	Township number	Range number
	Edwards	SW1/4 SW1/4 NE1/4	4	T 26 S	R 18 E/W

2. Distance and direction from nearest town or city: 1/2 n 2 w of Centerview
Street address of well location if in city:

3. Owner of well: Norma Nelson
R.R. or street:
City, state, zip code: Long Island, Ks.

4. Locate with "X" in section below:

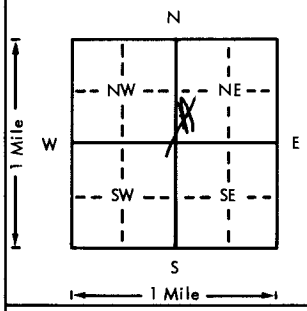

Sketch map:

6. Bore hole dia. 29 in. Completion date
Well depth 76 ft. 2-28-76

7. __ Cable tool ✓ Rotary __ Driven __ Dug
__ Hollow rod __ Jetted __ Bored __ Reverse rotary

8. Use: __ Domestic __ Public supply __ Industry
✓ Irrigation __ Air conditioning __ Stock
__ Lawn __ Oil field water __ Other

9. Casing: Material Steel Height: (Above) or below
Threaded ___ Welded ✓ Surface 18 in.
RMP ___ PVC ___ Weight ___ lbs./ft.
Dia. 16 in. to 76 ft. depth Wall Thickness: inches or
Dia. ___ in. to ___ ft. depth gage No. 7

5. Type and color of material	From	To
Top Soil	0	2
Brown Clay	2	12
Red & Yellow Brown Clay	12	16
Green Clay	16	21
Sand & Gravel	21	78
Brown Clay	78	81
Fire Clay	81	85
(Use a second sheet if needed)		

10. Screen: Manufacturer's name Doerr
Type Steel Dia. 16
Slot/gauze 3/16 Length 20
Set between 56 ft. and 76 ft.
ft. and ft.
Gravel pack? ✓ Size range of material 1/2 3/4 ~~3/8~~

11. Static water level: mo./day/yr.
18 ft. below land surface Date 12-19-76

12. Pumping level below land surfaces:
22 ft. after 1/2 hrs. pumping 500 g.p.m.
___ ft. after ___ hrs. pumping ___ g.p.m.
Estimated maximum yield 800 g.p.m.

13. Water sample submitted: mo./day/yr.
✓ Yes ___ No Date 12-19-76

14. Well head completion:
___ Pitless adapter ___ Inches above grade

15. Well grouted? ✓
With: ___ Neat cement ___ Bentonite ___ Concrete
Depth: From 0 ft. to 10 ft.

16. Nearest source of possible contamination:
ft. 1 Direction W Type Corral
Well disinfected upon completion? ___ Yes ___ No

17. Pump: ___ Not installed
Manufacturer's name WLR
Model number 2-DH-10 HP 60 Volts ___
Length of drop pipe 70 ft. capacity ___ g.p.m.
Type:
___ Submersible ✓ Turbine
___ Jet ___ Reciprocating
___ Centrifugal ___ Other

T 26 R 18 (W) E Sec 4 1/4 SW 1/4 SW 1/4

18. Elevation:

Topography:
___ Hill
___ Slope
✓ Upland
___ Valley

19. Remarks:

20. Water well contractor's certification:
This well was drilled under my jurisdiction and this report is true to the best of my knowledge and belief.
Business name Rosencrantz - Bennis License No. 134
Address Great Bend, Ks.
Signed Fredia Dobson Date 9/29/76
Authorized representative

Forward the white, blue and pink copies to the Department of Health and Environment

Form WWC-5

MI-1023