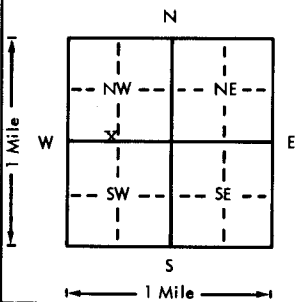


USE TYPEWRITER OR BALL
POINT PEN-PRESS FIRMLY,
PRINT CLEARLY.

WATER WELL RECORD
KSA 82a-1201-1215

Kansas Department of Health and
Environment-Division of Environment
(Water well Contractors)
Topeka, Kansas 66620

1. Location of well:		County Edwards	Fraction 1/4 SW 1/4 NW 1/4	Section number 30	Township number T 26 S	Range number R 18 E
2. Distance and direction from nearest town or city: 14 mi. Southeast of Kinsley, KS Street address of well location if in city:				3. Owner of well: Jim Kline R.R. or street: Route 1 City, state, zip code: Kinsley, KS 67547		
4. Locate with "X" in section below:		Sketch map:		6. Bore hole dia. <u>24</u> in. Completion date <u>2-25-76</u> Well depth <u>131</u> ft.		
				7. <input type="checkbox"/> Cable tool <input type="checkbox"/> Rotary <input type="checkbox"/> Driven <input type="checkbox"/> Dug <input type="checkbox"/> Hollow rod <input type="checkbox"/> Jetted <input type="checkbox"/> Bored <input checked="" type="checkbox"/> Reverse rotary		
5. Type and color of material		From	To	8. Use: <input type="checkbox"/> Domestic <input type="checkbox"/> Public supply <input type="checkbox"/> Industry <input checked="" type="checkbox"/> Irrigation <input type="checkbox"/> Air conditioning <input type="checkbox"/> Stock <input type="checkbox"/> Lawn <input type="checkbox"/> Oil field water <input type="checkbox"/> Other		
Top soil		0	4	9. Casing: Material <u>Steel</u> Height: <u>Above</u> or below Threaded <input type="checkbox"/> Welded <input checked="" type="checkbox"/> Surface <u>12</u> in. RMP <input type="checkbox"/> PVC <input type="checkbox"/> Weight <u>30.3</u> lbs./ft.		
Brown clay		4	14	Dial <u>16</u> in. to <u>50</u> ft. depth Wall Thickness: inches or Dial <u>16</u> in. to <u>100</u> ft. depth gauge No. <u>7 ga.</u>		
Sand & gravel		14	39	10. Screen: Manufacturer's name <u>W. A. Brown</u> Type <u>Double-slot</u> Dia. <u>16"</u> Slot/gauge <u>1/8</u> Length <u>61'</u> Set between <u>50</u> ft. and <u>80</u> ft. <u>100</u> ft. and <u>131</u> ft. Gravel pack? <u>Yes</u> Size range of material <u>3/8-200</u>		
White clay & gravel streaks		39	41	11. Static water level: _____ mo./day/yr. <u>26 1/2</u> ft. below land surface Date <u>2-10-76</u>		
Sand & gravel		41	67	12. Pumping level below land surfaces: <u>N/C</u> _____ ft. after _____ hrs. pumping _____ g.p.m. _____ ft. after _____ hrs. pumping _____ g.p.m. Estimated maximum yield _____ g.p.m.		
White & yellow clay & limestone		67	71	13. Water sample submitted: _____ mo./day/yr. Yes <input type="checkbox"/> No <input checked="" type="checkbox"/> Date _____		
Sand & gravel		71	78	14. Well head completion: <input type="checkbox"/> Pitless adapter <u>12</u> inches above grade		
Brown & white clay & limestone		78	98	15. Well grouted? <u>Yes</u> With: <input checked="" type="checkbox"/> Neat cement <input type="checkbox"/> Bentonite <input type="checkbox"/> Concrete Depth: From <u>0</u> ft. to <u>10</u> ft.		
Sand & gravel		98	110	16. Nearest source of possible contamination: ft. _____ Direction _____ Type _____ Well disinfected upon completion? Yes <input type="checkbox"/> No <input checked="" type="checkbox"/>		
Brown & gray clay & limestone		110	123	17. Pump: _____ Not installed Manufacturer's name <u>FMC Corp./Peerless</u> Model number <u>12LB-3</u> HP <u>80</u> Volts _____ Length of drop pipe <u>70</u> ft. capacity <u>900</u> g.p.m. Type: <input type="checkbox"/> Submersible <input checked="" type="checkbox"/> Turbine <input type="checkbox"/> Jet <input type="checkbox"/> Reciprocating <input type="checkbox"/> Centrifugal <input type="checkbox"/> Other		
Sand & gravel		123	130	20. Water well contractor's certification: This well was drilled under my jurisdiction and this report is true to the best of my knowledge and belief. <u>Clarke Well & Eq., Inc.</u> <u>185</u> Business name License No. Address <u>Great Bend, KS</u> Signed <u>[Signature]</u> Date <u>3-15-76</u> Authorized representative		
Brown clay		130	131			
(Use a second sheet if needed)						
18. Elevation:		19. Remarks:				
Topography: <input type="checkbox"/> Hill <input type="checkbox"/> Slope <input type="checkbox"/> Upland <input type="checkbox"/> Valley						

Forward the white, blue and pink copies to the Department of Health and Environment

Form WWC-3