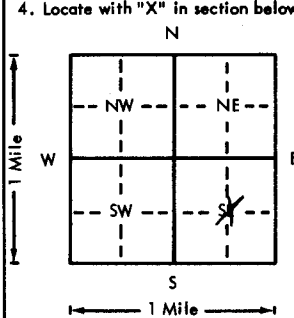


USE TYPEWRITER OR BALL
POINT PEN-PRESS FIRMLY,
PRINT CLEARLY.

WATER WELL RECORD
KSA 82a-1201-1215

Kansas Department of Health and
Environment-Division of Environment
(Water well Contractors)
Topeka, Kansas 66620

1. Location of well:		County <i>Edwards</i>	Fraction <i>1/4 C 1/4 SE 1/4</i>	Section number <i>31</i>	Township number <i>T 26 S</i>	Range number <i>R 18 E</i>
4. Locate with "X" in section below: 				Sketch map:		
5. Type and color of material				From	To	
<i>Top soil</i>				<i>0</i>	<i>2</i>	
<i>Brown clay</i>				<i>2</i>	<i>4</i>	
<i>Gray clay</i>				<i>4</i>	<i>6</i>	
<i>Red clay</i>				<i>6</i>	<i>13</i>	
<i>Red clay w/ sand + gravel</i>				<i>13</i>	<i>31</i>	
<i>Red clay</i>				<i>31</i>	<i>33</i>	
<i>sand + gravel</i>				<i>33</i>	<i>34</i>	
<i>sand</i>				<i>34</i>	<i>74</i>	
<i>sand + white rock</i>				<i>74</i>	<i>89</i>	
<i>sand + gravel white clay</i>				<i>89</i>	<i>127</i>	
<i>Brown clay white rock</i>				<i>127</i>	<i>131</i>	
<i>sand + gravel</i>				<i>131</i>	<i>135</i>	
<i>Brown clay</i>				<i>135</i>	<i>141</i>	
<i>sand + gravel</i>				<i>141</i>	<i>167</i>	
<i>Gray + yellow clay w/ white rock</i>				<i>167</i>	<i>171</i>	
(Use a second sheet if needed)						
18. Elevation: <i>2200</i>		19. Remarks: <i>26473</i> <i>26 18 31 NW 4</i>				
Topography: ☐ Hill ☒ Slope ☐ Upland ☐ Valley		20. Water well contractor's certification: This well was drilled under my jurisdiction and this report is true to the best of my knowledge and belief. <i>Rosenkrantz Bros</i> License No. <i>134</i> Business name: <i>Great Bend, KS</i> Address: <i>Media Kaden</i> Signed: <i>Media Kaden</i> Date: <i>9/10/76</i> Authorized representative				

Forward the white, blue and pink copies to the Department of Health and Environment

Form WWC-5