

WATER WELL RECORD

Form WWC-5

Division of Water Resources; App. No.

20060251

1 LOCATION OF WATER WELL: County: Edwards Fraction NE 1/4 NW 1/4 NW 1/4 Section Number 20 Township Number T 26 S Range Number R18W E/W Distance and direction from nearest town or city street address of well if located within city? 2 1/2S, 2W of Centerview, KS Global Positioning Systems (decimal degrees, min. of 4 digits) Latitude: Longitude: Elevation: Datum: Data Collection Method:

2 WATER WELL OWNER: Warren Sturgeon RR#, St. Address, Box # : Box 932 City, State, ZIP Code : Greensburg, KS 67054 3 LOCATE WELL'S LOCATION WITH AN "X" IN SECTION BOX: N E S W 4 DEPTH OF COMPLETED WELL140..... ft. Depth(s) Groundwater Encountered (1)...55..... ft. (2)..... ft. (3)..... ft. WELL'S STATIC WATER LEVEL.....55..... ft. below land surface measured on mo/day/yr. 06/23/06.. Pump test data: Well water was.....ft. after..... hours pumping..... gpm Est. Yield...80...gpm: Well water was.....ft. after..... hours pumping..... gpm WELL WATER TO BE USED AS: 5 Public water supply 8 Air conditioning 11 Injection well 1 Domestic 3 Feedlot 6 Oil field water supply 9 Dewatering 12 Other (Specify below) 2 Irrigation 4 Industrial 7 Domestic (lawn & garden) 10 Monitoring well Was a chemical/bacteriological sample submitted to Department? YesNo; If yes, mo/day/yr Sample was submitted..... Water well disinfected? Yes No

5 TYPE OF CASING USED: 5 Wrought Iron 8 Concrete tile CASING JOINTS: Glued..... Clamped..... 1 Steel 3 RMP (SR) 6 Asbestos-Cement 9 Other (specify below) Welded..... 2 PVC 4 ABS 7 Fiberglass Threaded..... Blank casing diameter5..... in. to ...120..... ft., Diameter. in. to ft., Diameter in. toft. Casing height above land surface.....12..... in., Weight.....2.8.....lbs./ft. Wall thickness or guage No. ..Sch.40..... TYPE OF SCREEN OR PERFORATION MATERIAL: 1 Steel 3 Stainless Steel 5 Fiberglass 7 PVC 9 ABS 11 Other (Specify) 2 Brass 4 Galvanized Steel 6 Concrete tile 8 RM (SR) 10 Asbestos-Cement 12 None used (open hole) SCREEN OR PERFORATION OPENINGS ARE: 1 Continuous slot 3 Mill slot 5 Guazed wrapped 7 Torch cut 9 Drilled holes 11 None (open hole) 2 Louvered shutter 4 Key punched 6 Wire wrapped 8 Saw Cut 10 Other (specify) SCREEN-PERFORATED INTERVALS: From.....120..... ft. to140..... ft., From ft. to ft. From ft. to ft. GRAVEL PACK INTERVALS: From.....22..... ft. to140..... ft., From ft. to ft. From ft. to ft.

6 GROUT MATERIAL: 1 Neat cement 2 Cement grout 3 Bentonite 4 Other Grout Intervals: From ...0..... ft. to ...22..... ft., From ft. to ft., From ft. toft. What is the nearest source of possible contamination: 1 Septic tank 4 Lateral lines 7 Pit privy 10 Livestock pens 13 Insecticide Storage 16 Other (specify 2 Sewer lines 5 Cess pool 8 Sewage lagoon 11 Fuel storage 14 Abandoned water well below) 3 Watertight sewer lines 6 Seepage pit 9 Feedyard 12 Fertilizer Storage 15 Oil well/gas well Direction from well?South..... How many feet? ..640.....

Table with 2 main columns: LITHOLOGIC LOG and PLUGGING INTERVALS. LITHOLOGIC LOG: FROM TO top soil 0 3 clay 3 22 sand and gravel 22 75 clay 75 115 sand and gravel 115 140 PLUGGING INTERVALS: Sturgeon A1-20 Sterling Drilling Company P. O. Box 1006 Pratt, KS 67124

7 CONTRACTOR'S OR LANDOWNER'S CERTIFICATION: This water well was (1) constructed, (2) reconstructed, or (3) plugged under my jurisdiction and was completed on (mo/day/year) .06/23/06.... and this record is true to the best of my knowledge and belief. Kansas Water Well Contractor's License No. ..186..... This Water Well Record was completed on (mo/day/year) 07/10/06..... under the business name of Kelly's Water Well Service, Inc. by (signature) Kathryn Good

INSTRUCTIONS: Use typewriter or ball point pen. PLEASE PRESS FIRMLY and PRINT clearly. Please fill in blanks, underline or circle the correct answers. Send top three copies to Kansas Department of Health and Environment, Bureau of Water, Geology Section, 1000 SW Jackson St., Suite 420, Topeka, Kansas 66612-1367. Telephone 785-296-5522. Send one to WATER WELL OWNER and retain one for your records. Fee of \$5.00 for each constructed well. Visit us at http://www.kdhe.state.ks.us/geo/waterwells.

STERLING DRILLING COMPANY

P.O. Box 1006
Pratt, Kansas 67124-1006
Phone (620) 672-9508
Federal ID #: 48-1185919


WATER WELL ACCEPTANCE AGREEMENT

Water Well Name: Sturgeon 'A' 1-20

Water Well Location: Section 20 Township 26 19w 18w
County Edwards

Water Well Location (footage): 4590' FSL & 4160 FEL Section 20

Board of Agriculture, Division of Water Resources Application Number: 20060251

 

This agreement between Sterling Drilling Company, P.O. Box 1006, Pratt, Kansas, 67124, and

Warren Sturgeon

certifies that they accept the above listed water well that was drilled by Kelly's Water Well Service, Great Bend, Kansas, located approximately 4590' FSL & 4160 FEL of Section 20 Township 26 Range 18w Edwards County Kansas for domestic use only and when the well is no longer needed agrees to plug the well in accordance with the State Regulation KAR 28-30-7.

By signing this agreement, landowner releases Sterling Drilling Company from any further responsibilities relating to the water well described above. Landowner also agrees to allow Sterling Drilling use of this water well for any future drilling operations within 3,000 feet of this water well and occurring within the next 3 years from this date. A fee of \$250.00 would be paid to the landowner each time Sterling used this water well for said purpose. Sterling Drilling would be responsible for payment of any fees for state and/or county permits required at that time.

October 16, 2006
Date

Gary M Talbot
Gary M Talbot, VP of Sterling Drilling

Oct 28, 2006
Date

Warren Sturgeon
Warren Sturgeon
Landowner

Copy of the WWC-5 and permits attached

RECEIVED
NOV 06 2006
BUREAU OF WATER