

County: Edwards Fraction C 52 Sec. 33 T 26 S R 18 E/W

CORRECTION(S) TO WATER WELL COMPLETION RECORD (WWC-5)

(to rectify lacking or incorrect information)

Owner: Ki Gamble

Location was listed as:

Location changed to:

Section-Township-Range: 33-26S-18W

33-26S-18W

Fraction (1/4 1/4 1/4): NW SW SE

C 52

Other changes: Initial statements: Kiowa County

Changed to: Edwards County

Comments: _____

Verification method: Legal & written descriptions, and mapping tool
& aerial photos on KGS website.

initials: DRA date: 10/26/2015

Submitted by: Kansas Geological Survey, Data Resources Library, 1930 Constant Ave., Lawrence, KS 66047-3726

to: Kansas Dept of Health & Environment, Bureau of Water, 1000 SW Jackson, Suite 420, Topeka, KS 66612-1367.


WATER WELL RECORD Form WWC-5 KSA 82a-1212

1 LOCATION OF WATER WELL: Fraction Section Number Township Number Range Number
 COUNTY: KIOWA NW 1/4 SW 1/4 SE 1/4 33 T 26 S R 18 W

Distance and direction from nearest town or city street address of well if located within city?
 8 MILES NORTH OF GREENSBURG

2 WATER WELL OWNER: GAMBLE, KI Board of Agriculture, Division of Water Resources
 RR#, St. Address, Box #: 16134 30TH AVE Application Number:
 City, State, ZIP code: GREENSBURG, KS 67054-

3 LOCATE WELL'S LOCATION WITH AN "X" IN SECTION BOX:

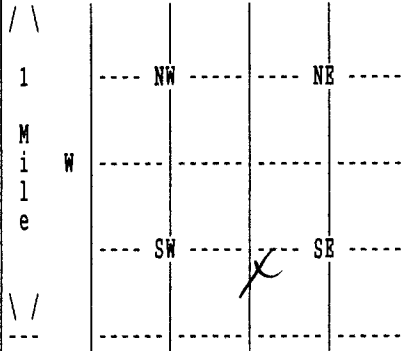

4 DEPTH OF COMPLETED WELL 140 ELEVATION: 0
 Depth(s) Groundwater Encountered 1. 0 ft. 2. 0 ft. 3. 0 ft.
 WELL'S STATIC WATER LEVEL 63 ft. below land surface measured on mo/day/yr 07/09/14
 Pump test data: Well water was 0 ft. after 0 hours pumping 0 gpm
 Estimated Yield 0 gpm: Well water was 0 ft. after 0 hours pumping 0 gpm
 Bore Hole Diameter 8.75 in. to 140 ft., and in. to 0 ft.
 WELL WATER TO BE USED AS: LIVESTOCK
 Was a chemical/bacteriological sample submitted to department? No ;
 If yes, mo/day/yr sample was submitted Water well disinfected? Yes

5 TYPE OF BLANK CASING USED: PVC CASING JOINTS: GLUED
 Blank casing diameter 5 in. to 120 ft., Dia in. to 0 ft., Dia in. to 0 ft.
 Casing height above land surface 24 in., weight 0 lbs/ft. Wall thickness or gauge No. 26
 TYPE OF SCREEN OR PERFORATION MATERIAL: PVC
 SCREEN OR PERFORATION OPENINGS ARE: SAW CUT

SCREEN PERFORATED INTERVALS: From 120 ft. to 140 ft., From 0 ft. to 0 ft.
 From 0 ft. to 0 ft., From 0 ft. to 0 ft.
 GRAVEL PACK INTERVALS: From 25 ft. to 140 ft., From 0 ft. to 0 ft.
 From 0 ft. to 0 ft., From 0 ft. to 0 ft.

6 GROUT MATERIAL BENTONITE
 Grout Intervals: From 1 ft. to 25 ft., From 0 ft. to 0 ft., From 0 ft. to 0 ft.
 What is the nearest source of possible contamination: OIL/GAS WELL
 Direction from well? EAST How many feet? 1200

FROM	TO	LITHOLOGIC LOG	FROM	TO	PLUGGING INTERVALS
0	8	SILT AND SAND			
8	48	TAN CLAY			
48	103	SAND AND GRAVEL			
103	109	TAN CLAY			
109	115	SAND AND GRAVEL			
115	121	TAN CLAY			
121	140	SAND AND GRAVEL			

7 CONTRACTOR'S OR LANDOWNER'S CERTIFICATION: This water well was Constructed under my jurisdiction and was completed on (mo/day/year) 07/09/14 and this record is true to the best of my knowledge and belief. Kansas Water Well Contractor's License No. 653 This Water Well Record was completed on (mo/day/yr) 09/29/14 under the business name of DAN HAYSE WATER WELL SERV by (signature) Dan Hayse