

1 LOCATION OF WATER WELL:		Fraction		Section Number		Township Number		Range Number	
County: Edwards		NE 1/4 SE 1/4 SW 1/4		5		T 26 S		R 19 E W	

Distance and direction from nearest town or city street address of well if located within city?

6 South of Kinsley, Kansas

2 WATER WELL OWNER: **Lewis Brothers**
RR#, St. Address, Box # : **Kinsley, Kansas**
City, State, ZIP Code :

Board of Agriculture, Division of Water Resources
Application Number:

3 LOCATE WELL'S LOCATION WITH AN "X" IN SECTION BOX:

4. DEPTH OF COMPLETED WELL: 40 ft. ELEVATION: _____

Depth(s) Groundwater Encountered 1. 26 ft. 2. _____ ft. 3. _____ ft.

WELL'S STATIC WATER LEVEL 26 ft. below land surface measured on mo/day/yr 4/27/87

Pump test data: Well water was 26 ft. after 1 hours pumping 3 gpm

Est. Yield 20 gpm: Well water was _____ ft. after _____ hours pumping _____ gpm


Bore Hole Diameter 8 3/4 in. to 40 ft., and _____ in. to _____ ft.

WELL WATER TO BE USED AS:

<input checked="" type="checkbox"/> Domestic	3 Feedlot	6 Oil field water supply	9 Dewatering	12 Other (Specify below)
2 Irrigation	4 Industrial	7 Lawn and garden only	10 Observation well	

Was a chemical/bacteriological sample submitted to Department? Yes _____ No ☒ _____; If yes, mo/day/yr sample was submitted _____

Water Well Disinfected? Yes ☒ No _____

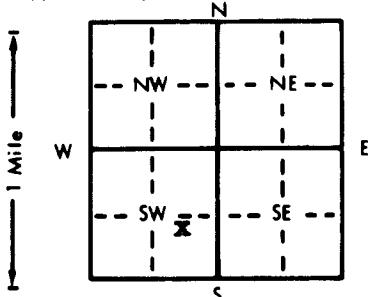

5	TYPE OF BLANK CASING USED:		5 Wrought iron	8 Concrete tile	CASING JOINTS: Glued . . . <input checked="" type="checkbox"/> Clamped Welded Threaded
	1 Steel	3 RMP (SR)	6 Asbestos-Cement	9 Other (specify below)	
	2 PVC	4 ABS	7 Fiberglass		

Blank casing diameter **6** . . . in. to . . . **30** . . . ft., Dia in. to ft., Dia in. to ft.
Casing height above land surface **24** . . . in., weight . . . **SDR21** . . . lbs./ft. Wall thickness or gauge No.

TYPE OF SCREEN OR PERFORATION MATERIAL:			<input checked="" type="checkbox"/> PVC	10 Asbestos-cement
1 Steel	3 Stainless steel	5 Fiberglass	8 RMP (SR)	11 Other (specify)
2 Brass	4 Galvanized steel	6 Concrete tile	9 ABS	12 None used (open hole)

SCREEN OR PERFORATION OPENINGS ARE:

1 Continuous slot	3 Mill slot	5 Gauzed wrapped	7 Saw cut	11 None (open hole)
2 Louvered shutter	4 Key punched	6 Wire wrapped	9 Drilled holes	
		7 Torch cut	10 Other (specify)	

SCREEN-PERFORATED INTERVALS: From 30 ft. to 40 ft., From _____ ft. to _____ ft.
From _____ ft. to _____ ft., From _____ ft. to _____ ft.
GRAVEL PACK INTERVALS: From 20 ft. to 40 ft., From _____ ft. to _____ ft.
From _____ ft. to _____ ft., From _____ ft. to _____ ft.

6 GROUT MATERIAL: ☒ Neat cement 2 Cement grout 3 Bentonite 4 Other

Grout Intervals: From 0 ft. to 20 ft. From ft. to ft. From ft. to ft.

What is the nearest source of possible contamination:

1 Septic tank	4 Lateral lines	7 Pit privy	10 Livestock pens	14 Abandoned water well
2 Sewer lines	5 Cess pool	8 Sewage lagoon	11 Fuel storage	15 Oil well/Gas well
3 Watertight sewer lines	6 Seepage pit	9 Feedyard	12 Fertilizer storage	16 Other (specify below)
			13 Insecticide storage	Cattle

Direction from well?	Pasture	How many feet?
----------------------	----------------	----------------

[illegible]

7 CONTRACTOR'S OR LANDOWNER'S CERTIFICATION: This water well was (1) constructed, (2) reconstructed, or (3) plugged under my jurisdiction and was completed on (mo/day/year) 4/27/87 and this record is true to the best of my knowledge and belief. Kansas

Water Well Contractor's License No. 224 This Water Well Record was completed on (mo./day/yr) 6-17-87
under the business name of Carl Hays Water Well Service by (signature) Carl Hays

INSTRUCTIONS: Use typewriter or ball point pen. PLEASE PRESS FIRMLY and PRINT clearly. Please fill in blanks, underline or circle the correct answers. Send top three copies to Kansas Department of Health and Environment, Bureau of Water Protection, Topeka, Kansas 66620-7320, Telephone: 913-862-9360. Send one to WATER WELL OWNER and retain one for your records.