WATER WELL RECORD Form WWC-5 KSA 82a-1212

1 LOCATION OF WATER WELL: County: Edwards	Fraction: 500'West C ¼ NW ¼	Section Number: 25	Township Number: T 26 S	Range Number: R 19 E/W

Distance and direction from nearest town or city street address of well if located within city? 3½ south 1½ east of Gibson

2 WATER WELL OWNER: Tom Fox
RR#, St. Address, Box # : 1310 Marsh
City, State, ZIP Code : Kinsley, Ks. 67547

Board of Agriculture, Division of Water Resources Application Number: 36,073

3 LOCATE WELL'S LOCATION WITH AN "X" IN SECTION BOX:

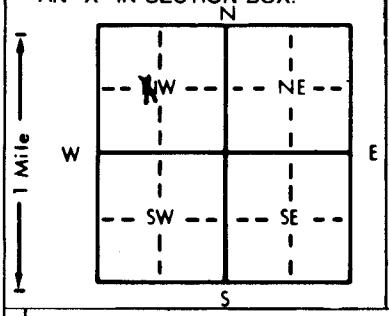

4 DEPTH OF COMPLETED WELL 134 ft. ELEVATION:
Depth(s) Groundwater Encountered 1. 27 ft. 2. ft. 3. ft.
WELL'S STATIC WATER LEVEL 45 ft. below land surface measured on mo/day/yr 6-9-82
Pump test data: Well water was 83 ft. after 1 hours pumping 1000 gpm
Est. Yield 1000 gpm: Well water was 87 ft. after 1½ hours pumping 1100 gpm
Bore Hole Diameter 29 in. to 134 ft., and in. to ft.
WELL WATER TO BE USED AS: 1 Domestic 2 Irrigation 3 Feedlot 4 Industrial 5 Public water supply 6 Oil field water supply 7 Lawn and garden only 8 Air conditioning 9 Dewatering 10 Observation well 11 Injection well 12 Other (Specify below)
Was a chemical/bacteriological sample submitted to Department? Yes No x; If yes, mo/day/yr sample was submitted
Water Well Disinfected? Yes HTH No

5 TYPE OF BLANK CASING USED: 1 Steel 2 PVC 3 RMP (SR) 4 ABS 5 Wrought iron 6 Asbestos-Cement 7 Fiberglass 8 Concrete tile 9 Other (specify below)
CASING JOINTS: Glued Clamped Welded x Threaded
Blank casing diameter 16 in. to 74 ft., Dia 16 in. to 99 ft., Dia in. to ft.
Casing height above land surface 24 in., weight lbs./ft. Wall thickness or gauge No. .7
TYPE OF SCREEN OR PERFORATION MATERIAL: 1 Steel 2 Brass 3 Stainless steel 4 Galvanized steel 5 Fiberglass 6 Concrete tile 7 PVC 8 RMP (SR) 9 ABS 10 Asbestos-cement 11 Other (specify) 12 None used (open hole)
SCREEN OR PERFORATION OPENINGS ARE: 1 Continuous slot 2 Louvered shutter 3 Mill slot 4 Key punched 5 Gauzed wrapped 6 Wire wrapped 7 Torch cut 8 Saw cut 9 Drilled holes 10 Other (specify) 11 None (open hole)
SCREEN-PERFORATED INTERVALS: From 74 ft. to 79 ft., From ft. to ft.
From 99 ft. to 134 ft., From ft. to ft.
GRAVEL PACK INTERVALS: From 10 ft. to 134 ft., From ft. to ft.
From ft. to ft., From ft. to ft.

6 GROUT MATERIAL: 1 Neat cement 2 Cement grout 3 Bentonite 4 Other
Grout Intervals: From 0 ft. to 10 ft., From ft. to ft., From ft. to ft.
What is the nearest source of possible contamination: 1 Septic tank 2 Sewer lines 3 Watertight sewer lines 4 Lateral lines 5 Cess pool 6 Seepage pit 7 Pit privy 8 Sewage lagoon 9 Feedyard 10 Livestock pens 11 Fuel storage 12 Fertilizer storage 13 Insecticide storage 14 Abandoned water well 15 Oil well/Gas well 16 Other (specify below) NONE
Direction from well? How many feet?

FROM	TO	LITHOLOGIC LOG	FROM	TO	LITHOLOGIC LOG
0	3	Top soil			
3	18 01	Brown clay			
18	78 17	Sand and gravel			
78	84 04	Fine sand and sandy clay			
84	97 01	Brown and white clay			
97	110 17	Sand and gravel-looseclean			
110	121 04	Brown clay-some skiffs of sand			
121	134 17	Sand and gravel-loose, med.			
134	01	Brown clay			

7 CONTRACTOR'S OR LANDOWNER'S CERTIFICATION: This water well was (1) constructed, (2) reconstructed, or (3) plugged under my jurisdiction and was completed on (mo/day/year) 4-27-83 and this record is true to the best of my knowledge and belief. Kansas Water Well Contractor's License No. 134 This Water Well Record was completed on (mo/day/yr) 5-18-83
under the business name of Rosencrantz-Bemis Ent. by (signature) Lora Dodson

INSTRUCTIONS: Use typewriter or ball point pen, *PLEASE PRESS FIRMLY* and *PRINT* clearly. Please fill in blanks, underline or circle the correct answers. Send top three copies to Kansas Department of Health and Environment, Division of Environment, Environmental Geology Section, Topeka, KS 66620. Send one to WATER WELL OWNER and retain one for your records.

OFFICE USE ONLY T 26 R 19 E/W SEC. 25 C ¼ NW ¼ NW ¼

D7