


2½ south of Gibson, Ks.

Board of Agriculture, Division of Water Resources
Application Number:

4 DEPTH OF COMPLETED WELL.....8.5..... ft. ELEVATION:

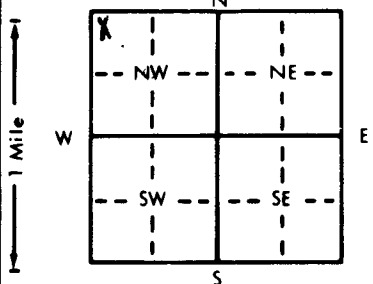

Depth(s) Groundwater Encountered 1. ft. 2. ft. 3. ft.

Pump test data: Well water was ft. after hours pumping gpm

Bore Hole Diameter . . . 9 . . . in. to . . . 85 . . . ft., and . . . in. to . . . ft.

1 Domestic 3 Feedlot 6 Oil field water supply 9 Dewatering 12 Other (Specify below)

2 Irrigation 4 Industrial 7 Lawn and garden only 10 Monitoring welllive stock.....

Was a chemical/bacteriological sample submitted to Department? Yes.....No.....**X**...; If yes, mo/day/yr sample was submitted
Water Well Disinfected? Yes **hth** No

Blank casing diameter 5 . . . in. to . . . 65 . . . ft. Dia . . . in. to . . . ft. Dia . . . in. to . . . ft.

Casing height above land surface..... 21 in., weight SDR 26..... lbs./ft. Wall thickness or gauge No.

1 Steel 3 Stainless steel 5 Fiberglass 8 RMP (SR) 11 Other (specify)

2 Brass	4 Galvanized steel	6 Concrete tile	9 ABS	12 None used (open hole)
---------	--------------------	-----------------	-------	--------------------------

SCREEN OR PERFORATION OPENINGS ARE: 5 Gauzed wrapped 8 Saw cut 11 None (open hole)

1 Continuous slot 3 Mill slot 6 Wire wrapped 9 Drilled holes

2 Louvered shutter 4 Key punched 7 Torch cut 10 Other (specify)

SCREEN-PERFORATED INTERVALS: From 8.5 ft. to 6.5 ft. From ft. to ft.

From ft. to ft. From ft. to ft.

GRAVEL PACK INTERVALS: From 85 ft. to 20 ft., From ft. to ft.

From _____ ft. to _____ ft., From _____ ft. to _____ ft.

6	GROUT MATERIAL:	1 Neat cement	2 Cement grout	3 Bentonite	4 Other ... hole plug
---	-----------------	---------------	----------------	-------------	-----------------------------

Grout Intervals: From 20 ft. to 0 ft., From 0 ft. to 0 ft., From 0 ft. to 0 ft.

What is the nearest source of possible contamination: 10 Livestock pens 14 Abandoned water well

1 Septic tank	4 Lateral lines	7 Pit privy	11 Fuel storage	15 Oil well/Gas well
---------------	-----------------	-------------	-----------------	----------------------

2 Sewer lines	5 Cess pool	8 Sewage lagoon	12 Fertilizer storage	16 Other (specify below)
---------------	-------------	-----------------	-----------------------	--------------------------

3 Watertight sewer lines 6 Seepage pit 9 Feedyard 13 Insecticide storage irrigation well.....

Direction from well? south east How many feet? $\frac{1}{2}$ mile

FROM	TO	LITHOLOGIC LOG	FROM	TO	PLUGGING INTERVALS
------	----	----------------	------	----	--------------------

0	3	Top soil			
---	---	----------	--	--	--

3	7	Brown clay			
---	---	------------	--	--	--

7	19	Gray clay			
---	----	-----------	--	--	--

19	27	Sand & gravel clean coarse loose		
----	----	----------------------------------	--	--

27	30	Brown clay	
----	----	------------	--

27	90	Brown clay			
30	85	Sand & gravel clean coarse loose			

7 CONTRACTOR'S OR LANDOWNER'S CERTIFICATION: This water well was (1) constructed, (2) reconstructed, or (3) plugged under my jurisdiction and was completed on (mo/day/year) 11-18-98 and this record is true to the best of my knowledge and belief. Kansas

Water Well Contractor's License No. 134 This Water Well Record was completed on (mo/day/yr) 11-20-98
under the business name of Rosencrantz-Bemis by (signature) Fredia Bedon