WATER WELL RECORD Form WWC-5 KSA 82a-1212

1 LOCATION OF WATER WELL:	Fraction	Section Number	Township Number	Range Number
County: Edwards	NW ¼ SE ¼ SW ¼	14	T 26 S	R 19 E/W

Distance and direction from nearest town or city street address of well if located within city?
2 1/8 south, ½ E. Gibson, Ks.

2 WATER WELL OWNER: Richard Wenstrom
RR#, St. Address, Box # : Rt. 1 Box 107
City, State, ZIP Code : Kinsley, Ks. 67547
Board of Agriculture, Division of Water Resources
Application Number: 33288

3 LOCATE WELL'S LOCATION WITH AN "X" IN SECTION BOX:

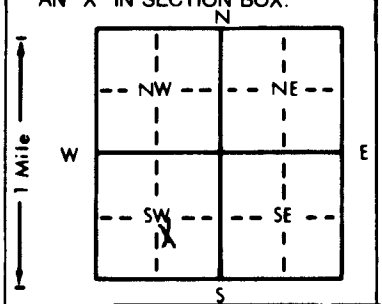

4 DEPTH OF COMPLETED WELL 213 ft. ELEVATION:
Depth(s) Groundwater Encountered 1. ft. 2. ft. 3. ft.
WELL'S STATIC WATER LEVEL 44 ft. below land surface measured on mo/day/yr 4-12-99
Pump test data: Well water was ft. after hours pumping gpm
Est. Yield 900 gpm: Well water was 108'3" ft. after 2½ hours pumping 700 gpm
Bore Hole Diameter 28 in. to 213 ft., and in. to ft.
WELL WATER TO BE USED AS: 1 Domestic 2 Irrigation 3 Feedlot 4 Industrial 5 Public water supply 6 Oil field water supply 7 Lawn and garden only 8 Air conditioning 9 Dewatering 10 Monitoring well 11 Injection well 12 Other (Specify below)
Was a chemical/bacteriological sample submitted to Department? Yes No X; If yes, mo/day/yr sample was submitted
Water Well Disinfected? Yes No X

5 TYPE OF BLANK CASING USED: 1 Steel 2 PVC 3 RMP (SR) 4 ABS 5 Wrought iron 6 Asbestos-Cement 7 Fiberglass 8 Concrete tile 9 Other (specify below)
CASING JOINTS: Glued X Clamped Welded Threaded
Blank casing diameter 16 in. to 113 ft., Dia 16 in. to 133-153 ft., Dia in. to ft.
Casing height above land surface 12 in., weight SDR 21.6 lbs./ft. Wall thickness or gauge No.

TYPE OF SCREEN OR PERFORATION MATERIAL: 7 PVC
1 Steel 2 Brass 3 Stainless steel 4 Galvanized steel 5 Fiberglass 6 Concrete tile 8 RMP (SR) 9 ABS 10 Asbestos-cement 11 Other (specify) 12 None used (open hole)

SCREEN OR PERFORATION OPENINGS ARE: 1 Continuous slot 2 Louvered shutter 3 Mill slot 4 Key punched 5 Gauzed wrapped 6 Wire wrapped 7 Torch cut 8 Saw cut 9 Drilled holes 10 Other (specify) 11 None (open hole)

SCREEN-PERFORATED INTERVALS: From 113 ft. to 133 ft., From ft. to ft.
From 153 ft. to 213 ft., From ft. to ft.
GRAVEL PACK INTERVALS: From 213 ft. to 20 ft., From ft. to ft.
From ft. to ft., From ft. to ft.

6 GROUT MATERIAL: 1 Neat cement 2 Cement grout 3 Bentonite 4 Other hole plug
Grout Intervals: From 20 ft. to 0 ft., From ft. to ft., From ft. to ft.

What is the nearest source of possible contamination:
1 Septic tank 2 Sewer lines 3 Watertight sewer lines 4 Lateral lines 5 Cess pool 6 Seepage pit 7 Pit privy 8 Sewage lagoon 9 Feedyard 10 Livestock pens 11 Fuel storage 12 Fertilizer storage 13 Insecticide storage 14 Abandoned water well 15 Oil well/Gas well 16 Other (specify below) none
Direction from well? How many feet?

FROM	TO	LITHOLOGIC LOG	FROM	TO	PLUGGING INTERVALS
0	3	Top soil	170	175	Fine sand and clay
3	20	Brown sandy soft clay	175	190	Fine sand and gravel clean and loose
20	50	Sand and gravel, coarse, loose,	190	191	Brown clay
50	58	Brown clay	191	200	Sand and gravel medium loose
58	74	Sand and gravel coarse, loose	200	209	Brown and white clay
74	80	Sand and gravel clay mixed	209	213	Sand and gravel coarse and loose
80	95	Brown and white clay			
95	101	Sand and gravel medium loose, clean			
101	125	Brown and white clay			
125	135	Sand and gravel medium, clean, loose			
135	140	Brown and white clay			
140	143	Fine sand clay mixed			
143	155	Brown and white clay			
155	167	Gritty brown and white clay			
167	170	Sandy gritty clay			

7 CONTRACTOR'S OR LANDOWNER'S CERTIFICATION: This water well was (1) constructed, (2) reconstructed, or (3) plugged under my jurisdiction and was completed on (mo/day/year) 4-29-99 and this record is true to the best of my knowledge and belief. Kansas Water Well Contractor's License No. 134 This Water Well Record was completed on (mo/day/yr)
under the business name of Rosencrantz-Bemis by (signature)

INSTRUCTIONS: Use typewriter or ball point pen. *PLEASE PRESS FIRMLY* and *PRINT* clearly. Please fill in blanks, underline or circle the correct answers. Send top three copies to Kansas Department of Health and Environment, Bureau of Water, Topeka, Kansas 66620-0001. Telephone: 913-296-5545. Send one to WATER WELL OWNER and retain one for your records.

OFFICE USE ONLY T R E/W SEC. ¼ ¼ ¼