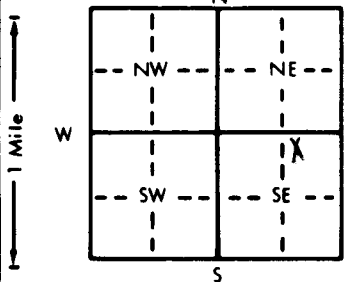


1 LOCATION OF WATER WELL:		Fraction		Section Number		Township Number		Range Number	
County: Edwards		NW 1/4 NE 1/4 SE 1/4		10		T 26 S		R 19 5W	
Distance and direction from nearest town or city street address of well if located within city? 1 1/4 miles south of Gibson, Ks..									
2 WATER WELL OWNER: Mica Schnoebelen									
RR#, St. Address, Box # : RR					Board of Agriculture, Division of Water Resources				
City, State, ZIP Code : Lewis, Ks. 67552					Application Number:				
3 LOCATE WELL'S LOCATION WITH AN "X" IN SECTION BOX:		4 DEPTH OF COMPLETED WELL: 60 ft. ELEVATION:							
		Depth(s) Groundwater Encountered 1. ft. 2. ft. 3. ft. WELL'S STATIC WATER LEVEL 40 ft. below land surface measured on mo/day/yr 12-6-99 Pump test data: Well water was ft. after hours pumping gpm Est. Yield NA gpm: Well water was ft. after hours pumping gpm Bore Hole Diameter 9 7/8 in. to 60 ft. and in. to ft. WELL WATER TO BE USED AS: 5 Public water supply 8 Air conditioning 11 Injection well 1 Domestic 3 Feedlot 6 Oil field water supply 9 Dewatering 12 Other (Specify below) 2 Irrigation 4 Industrial 7 Lawn and garden only 10 Monitoring well Live Stock Was a chemical/bacteriological sample submitted to Department? Yes No X; If yes, mo/day/yr sample was submitted Water Well Disinfected? Yes HTH No							
5 TYPE OF BLANK CASING USED:									
1 Steel 3 RMP (SR) 5 Wrought iron 8 Concrete tile CASING JOINTS: Glued X Clamped									
2 PVC 4 ABS 6 Asbestos-Cement 9 Other (specify below) Welded									
7 Fiberglass Threaded									
Blank casing diameter 5 in. to 40 ft. Dia in. to ft. Dia in. to ft.									
Casing height above land surface 24 in., weight SDR 26 lbs./ft. Wall thickness or gauge No.									
TYPE OF SCREEN OR PERFORATION MATERIAL:									
1 Steel 3 Stainless steel 5 Fiberglass 7 PVC 10 Asbestos-cement									
2 Brass 4 Galvanized steel 6 Concrete tile 8 RMP (SR) 11 Other (specify)									
12 None used (open hole)									
SCREEN OR PERFORATION OPENINGS ARE:									
1 Continuous slot 3 Mill slot 5 Gauzed wrapped 8 Saw cut 11 None (open hole)									
2 Louvered shutter 4 Key punched 6 Wire wrapped 9 Drilled holes									
7 Torch cut 10 Other (specify)									
SCREEN-PERFORATED INTERVALS: From 40 ft. to 60 ft. From ft. to ft.									
From ft. to ft. From ft. to ft.									
GRAVEL PACK INTERVALS: From 60 ft. to 20 ft. From ft. to ft.									
From ft. to ft. From ft. to ft.									
6 GROUT MATERIAL: 1 Neat cement 2 Cement grout 3 Bentonite 4 Other Hole plug									
Grout Intervals: From 20 ft. to 0 ft. From ft. to ft. From ft. to ft.									
What is the nearest source of possible contamination:									
1 Septic tank 4 Lateral lines 7 Pit privy 10 Livestock pens 14 Abandoned water well									
2 Sewer lines 5 Cess pool 8 Sewage lagoon 11 Fuel storage 15 Oil well/Gas well									
3 Watertight sewer lines 6 Seepage pit 9 Feedyard 12 Fertilizer storage 16 Other (specify below)									
13 Insecticide storage None									
Direction from well? How many feet?									
FROM TO LITHOLOGIC LOG FROM TO PLUGGING INTERVALS									
0 3 Top soil									
3 10 Brown clay									
10 20 Gray clay									
20 24 Brown sandy clay									
24 60 Sand and gravel clean coarse loose									
7 CONTRACTOR'S OR LANDOWNER'S CERTIFICATION: This water well was (1) constructed, (2) reconstructed, or (3) plugged under my jurisdiction and was completed on (mo/day/year) 12-6-99 and this record is true to the best of my knowledge and belief. Kansas Water Well Contractor's License No. 134 This Water Well Record was completed on (mo/day/yr) 12-10-99 under the business name of Rosencrantz-Bemis by (signature) Mica Schnoebelen									
INSTRUCTIONS: Use typewriter or ball point pen. PLEASE PRESS FIRMLY and PRINT clearly. Please fill in blanks, underline or circle the correct answers. Send top three copies to Kansas Department of Health and Environment, Bureau of Water, Topeka, Kansas 66620-0001. Telephone: 913-296-5545. Send one to WATER WELL OWNER and retain one for your records.									