

WATER WELL RECORD

Form WWC-5


Division of Water Resources App. No.

1 LOCATION OF WATER WELL: County: Edwards Fraction 1/4 NW 1/4 SW 1/4 SE 1/4 Section Number 11 Township No. T 26 S Range Number R 19 E W

Street/Rural Address of Well Location; if unknown, distance & direction from nearest town or intersection: If at owner's address, check here [] 1 South, 5 1/2 West of Centerview

Global Positioning System (GPS) information: Latitude: Longitude: Elevation: Datum: Collection Method: Est. Accuracy:

2 WATER WELL OWNER: Mica & Sherrie Schnoebelen RR#, Street Address, Box #: 2065 U Road City, State, ZIP Code : Lewis, KS 67552

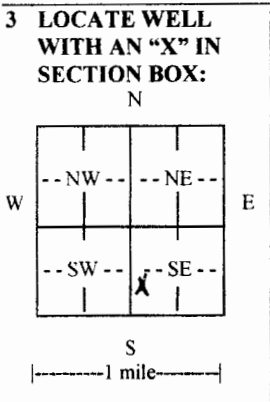

3 LOCATE WELL WITH AN 'X' IN SECTION BOX: 4 DEPTH OF COMPLETED WELL 145 ft. Depth(s) Groundwater Encountered (1)..... ft. (2)..... ft. (3)..... ft. WELL'S STATIC WATER LEVEL 60..... ft. below land surface measured on mo/day/yr. 2-23-16..... Pump test data: Well water was 80..... ft. after 3..... hours pumping. 870..... gpm EST. YIELD 911..... gpm. Well water was 81..... ft. after 3.1/2..... hours pumping. 911..... gpm Bore Hole Diameter 40..... in. to 145..... ft., and in. to ft. WELL WATER TO BE USED AS: [] Public water supply [] Geothermal [] Injection well [] Domestic [] Feedlot [] Oil field water supply [] Dewatering [] Other (Specify below) [x] Irrigation [] Industrial [] Domestic-lawn & garden [] Monitoring well Was a chemical/bacteriological sample submitted to Department? [] Yes [x] No If yes, mo/day/yr sample was submitted..... Water well disinfected? [x] Yes [] No

5 TYPE OF CASING USED: [] Steel [x] PVC [] Other CASING JOINTS: [x] Glued [] Clamped [] Welded [] Threaded Casing diameter 16..... in. to 145..... ft., Diameter in. to ft., Diameter in. to ft. Casing height above land surface 18..... in., Weight Sch 40..... lbs./ft., Wall thickness or gauge No. TYPE OF SCREEN OR PERFORATION MATERIAL: [] Steel [x] Stainless Steel [x] PVC [] Other (Specify) [] Brass [] Galvanized Steel [] None used (open hole) SCREEN OR PERFORATION OPENINGS ARE: [] Continuous slot [] Mill slot [] Gauze wrapped [] Torch cut [] Drilled holes [] None (open hole) [] Louvered shutter [] Key punched [] Wire wrapped [x] Saw cut [] Other (specify) SCREEN-PERFORATED INTERVALS: From 145..... ft. to 75..... ft., From ft. to ft. From ft. to ft. GRAVEL PACK INTERVALS: From 145..... ft. to 20..... ft., From ft. to ft. From ft. to ft., From ft. to ft.

6 GROUT MATERIAL: [] Neat cement [] Cement grout [x] Bentonite [] Other Grout Intervals: From ft. to ft., From 20..... ft. to 0..... ft., From ft. to ft. What is the nearest source of possible contamination: [] Septic tank [] Lateral lines [] Pit privy [] Livestock pens [] Insecticide storage [x] Other (specify below) [] Sewer lines [] Cesspool [] Sewage lagoon [] Fuel storage [] Abandoned water well [] Watertight sewer lines [] Seepage pit [] Feedyard [] Fertilizer storage [] Oil well/gas well None Direction from well Distance from well

Table with columns: FROM, TO, LITHOLOGIC LOG, FROM, TO, LITHO. LOG (cont.) or PLUGGING INTERVALS. Rows include Sandy top soil, Brown clay, Sand & clay- mixed, Sand & gravel- med, Sand, Sand & gravel- med, coarse, Soft cemented sand & clay, Sand & gravel, Tan clay & caliche, Sand & gravel- fine to small.

7 CONTRACTOR'S OR LANDOWNER'S CERTIFICATION: This water well was [x] constructed, [] reconstructed, or [] plugged under my jurisdiction and was completed on (mo/day/year) 3-7-16..... and this record is true to the best of my knowledge and belief. Kansas Water Well Contractor's License No. 134..... This Water Well Record was completed on (mo/day/year) 4-11-16..... under the business name of Rosencrantz- Bemis Ent Inc..... by (signature) Sherrie Schnoebelen

INSTRUCTIONS: Use typewriter or ball point pen. PLEASE PRESS FIRMLY and PRINT clearly. Please fill in blanks and check the correct answers. Send one copy to Kansas Department of Health and Environment, Bureau of Water, Geology Section, 1000 SW Jackson St., Suite 420, Topeka, Kansas 66612-1367. Telephone 785-296-5524. Send one copy to WATER WELL OWNER and retain one for your records. Include fee of \$5.00 for each constructed well. Visit us at http://www.kdheks.gov/waterwell/index.html