


1 LOCATION OF WATER WELL: County: Sedgwick Fraction: NW 1/4 NE 1/4 SE 1/4 Section Number: 18 Township Number: T 26 S Range Number: R 2 E

Distance and direction from nearest town or city street address of well if located within city? See Below

2 WATER WELL OWNER: Bill Horvath  
 RR#, St. Address, Box #: 6151 N. 199th W.  
 City, State, ZIP Code: Edwin, KS 67030  
 Board of Agriculture, Division of Water Resources  
 Application Number:

3 LOCATE WELL'S LOCATION WITH AN "X" IN SECTION BOX: 51 ft. ELEVATION:

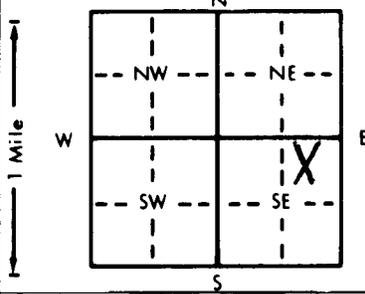

4 DEPTH OF COMPLETED WELL: 51 ft. ELEVATION:  
 Depth(s) Groundwater Encountered 1. 12 ft. 2. 10/5/95 ft. 3. 10/5/95 ft.  
 WELL'S STATIC WATER LEVEL: 12 ft. below land surface measured on mo/day/yr  
 Pump test data: Well water was 30 ft. after 11 hours pumping 51 gpm  
 Est. Yield 30 gpm Well water was 11 ft. after 51 hours pumping 51 gpm  
 Bore Hole Diameter: 11 in. to 51 ft., and 51 in. to 51 ft.  
 WELL WATER TO BE USED AS:  
 1 Domestic  3 Feedlot  6 Oil field water supply  9 Dewatering  12 Other (Specify below)  
 2 Irrigation  4 Industrial  7 Lawn and garden only  10 Monitoring well  
 Was a chemical/bacteriological sample submitted to Department? Yes X No X; If yes, mo/day/yr sample was submitted  
 Water Well Disinfected? Yes X No X

5 TYPE OF BLANK CASING USED:  
 1 Steel  3 RMP (SR)  5 Wrought iron  8 Concrete tile CASING JOINTS: Glued X Clamped X  
 2 PVC  4 ABS  6 Asbestos-Cement  9 Other (specify below) Welded X  
 7 Fiberglass Threaded X

Blank casing diameter: 5 in. to 39 ft., Dia. 12 in. to 51 ft., Dia. 160 PSI  
 Casing height above land surface: 12 in., weight 4.150 lbs./ft. Wall thickness or gauge No. 160 PSI

TYPE OF SCREEN OR PERFORATION MATERIAL:  
 1 Steel  3 Stainless steel  5 Fiberglass  7 PVC  10 Asbestos-cement  
 2 Brass  4 Galvanized steel  6 Concrete tile  8 RMP (SR)  11 Other (specify) 11  
 12 None used (open hole)

SCREEN OR PERFORATION OPENINGS ARE:  
 1 Continuous slot  3 Mill slot  5 Gauzed wrapped  8 Saw cut  11 None (open hole)  
 2 Louvered shutter  4 Key punched  6 Wire wrapped  9 Drilled holes  10 Other (specify)

SCREEN-PERFORATED INTERVALS: From 39 ft. to 51 ft., From 12 ft. to 51 ft.  
 GRAVEL PACK INTERVALS: From 12 ft. to 51 ft., From 12 ft. to 51 ft.

6 GROUT MATERIAL: 3 Neat cement 2 Cement grout  3 Bentonite  4 Other  
 Grout Intervals: From 3 ft. to 12 ft., From 12 ft. to 51 ft., From 12 ft. to 51 ft.

What is the nearest source of possible contamination:  
 1 Septic tank  4 Lateral lines  7 Pit privy  10 Livestock pens  14 Abandoned water well  
 2 Sewer lines  5 Cess pool  8 Sewage lagoon  11 Fuel storage  15 Oil well/Gas well  
 3 Watertight sewer lines  6 Seepage pit  9 Feedyard  12 Fertilizer storage  16 Other (specify below)  
 13 Insecticide storage  
 Direction from well? North How many feet? 65

FROM	TO	LITHOLOGIC LOG	FROM	TO	PLUGGING INTERVALS
0	2	Top soil			
2	20	clay			
20	30	fine sand			
30	31	clay			
31	51	medium sand			

7 CONTRACTOR'S OR LANDOWNER'S CERTIFICATION: This water well was (1) constructed, (2) reconstructed, or (3) plugged under my jurisdiction and was completed on (mo/day/year) 10/1/95 and this record is true to the best of my knowledge and belief. Kansas Water Well Contractor's License No. 318 This Water Well Record was completed on (mo/day/yr) 10/12/95 under the business name of Weninger Drilling, Inc. by (signature) Kathleen P. Brasen

OFFICE USE ONLY  
T  
R  
EW  
SEC.  
1/4  
1/4  
1/4