

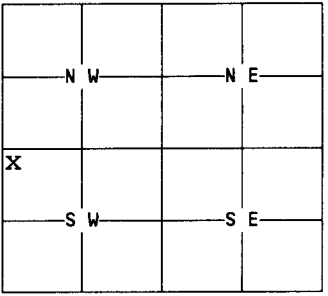
VMP#13

1	LOCATION OF WATER WELL: County: SEDGWICK	Fraction NW¹/₄ NW¹/₄ SW¹/₄	Section Number 1	Township Number 26	Range Number 2-W
---	--	--	----------------------------	------------------------------	----------------------------

Distance and direction from nearest town or city street address of well if located within city?

3 MILES NW OF MAIZE, KS

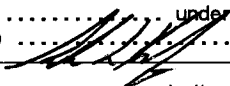
2	WATER WELL OWNER: CHASE PIPELINE CO. RR#, St. Address, Box #: 4711 E. 38th ST. NORTH City, State, ZIP Code: WICHITA, KS 67219	Board of Agriculture, Division of Water Resources Application Number:
---	--	--

3	MARK WELL'S LOCATION WITH AN "X" IN SECTION BOX: N  S	4	DEPTH OF WELL..... 8ft. WELL'S STATIC WATER LEVEL.....ft. WELL WAS USED AS: 1 Domestic 5 Public Water Supply 9 Dewatering 2 Irrigation 6 Oil Field Water Supply 10 Monitoring Well 3 Feedlot 7 Lawn and Garden Only 11 Injection Well 4 Industrial 8 Air Conditioning 12 Other..... vapor monitoring point Was a chemical/bacteriological sample submitted to Department? Yes....No.... If yes, mo/day/yr sample was submitted..... Water Well Disinfected: Yes..... No.....
---	---	---	--

5	TYPE OF BLANK CASING USED: 1 Steel 3 RMP (SR) 5 Wrought 7 Fiberglass 9 Other (specify below) 2 PVC 4 ABS 6 Asbestos-Cement 8 Concrete Tile Blank casing diameter.. 2in. Was casing pulled? Yes.. X ... No..... If yes, how much.. 3 Casing height above or below land surface.....in.
---	--

6	GROUT PLUG MATERIAL: 1 Neat cement 2 Cement grout X3 Bentonite 4 Other..... Grout Plug Intervals: From.. 8 ...ft. to.... 0 ...ft., From.....ft. toft., From..... to.....ft. What is the nearest source of possible contamination: 1 Septic tank 6 Seepage pit 11 Fuel storage 16 Other (specify below) 2 Sewer lines 7 Pit privy 12 Fertilizer storage 3 Watertight sewer lines 8 Sewage lagoon 13 Insecticide storage 4 Lateral lines 9 Feedyard 14 Abandoned water well 5 Cess Pool 10 Livestock pens 15 Oil well/Gas well Direction from well? .. north How many feet? 210
---	---

FROM	TO	PLUGGING MATERIALS
8	0	BENTONITE

7	CONTRACTOR'S OR LANDOWNER'S CERTIFICATION: This water well was plugged under my jurisdiction and was completed on (mo/day/year).... 1-28-99 and this record is true to the best of my knowledge and belief. Kansas Water Well Contractor's License No. 575 This Water Well Record was completed on (mo/day/year).... 3-2-99 under the business name of KURTZ ENVIRONMENTAL SERVICE by (signature) 
---	--

INSTRUCTIONS: Use typewriter or ball point pen. Please press firmly and print clearly. Please fill in blanks, underline or circle the correct answers. Send top three copies to Kansas Department of Health and Environment, Bureau of Water, Topeka, Kansas 66620-0001. Telephone: 785/296-3565. Send one to Water Well Owner and retain one for your records.