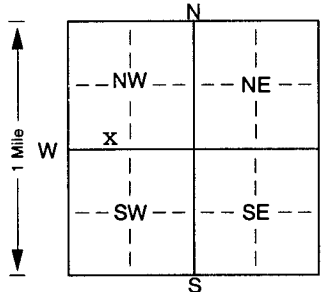


1 LOCATION OF WATER WELL:		Fraction		Section Number		Township Number		Range Number	
County: Sedgwick		SE 1/4 SW 1/4 NW 1/4		20		T 26 S		R 2 E/W	
Distance and direction from nearest town or city street address of well if located within city?									
Approximately 1 3/4 miles west and 1/2 mile south of Colwich									
2 WATER WELL OWNER: City of Colwich									
RR#, St. Address, Box # : 310 South Second					Board of Agriculture, Division of Water Resources				
City, State, ZIP Code : Colwich, KS 67030					Application Number: 41054, 42882, 42969				
3 LOCATE WELL'S LOCATION WITH		4 DEPTH OF COMPLETED WELL: 101.5 ft. ELEVATION: unknown							
AN "X" IN SECTION BOX:		Depth(s) Groundwater Encountered 1. ft. 2. ft. 3. ft.							
		WELL'S STATIC WATER LEVEL 30 ft. below land surface measured on mo/day/yr 1-5-01							
		Pump test data: Well water was not ch'd ft. after hours pumping gpm							
		Est. Yield unknown gpm: Well water was ft. after hours pumping gpm							
		Bore Hole Diameter 42 in. to 100 ft., and in. to ft.							
		WELL WATER TO BE USED AS: 5 Public water supply 8 Air conditioning 11 Injection well							
		1 Domestic 3 Feedlot 6 Oil field water supply 9 Dewatering 12 Other (Specify below)							
		2 Irrigation 4 Industrial 7 Domestic (lawn & garden) 10 Monitoring well							
Was a chemical/bacteriological sample submitted to Department? Yes. No. X; If yes, mo/day/yr sample was submitted									
Water Well Disinfected? Yes X No									
5 TYPE OF BLANK CASING USED:									
1 Steel 3 RMP (SR) 5 Wrought iron 8 Concrete tile CASING JOINTS: Glued. Clamped.									
2 PVC 4 ABS 6 Asbestos-Cement 9 Other (specify below) Welded X									
7 Fiberglass Threaded.									
Blank casing diameter 12 in. to 74.5 ft., Dia 12 in. to 100 ft., Dia in. to ft.									
Casing height above land surface 18 in., weight 49.56 lbs./ft. Wall thickness or gauge No. 375									
TYPE OF SCREEN OR PERFORATION MATERIAL:									
1 Steel 3 Stainless steel 5 Fiberglass 7 PVC 10 Asbestos-cement									
2 Brass 4 Galvanized steel 6 Concrete tile 8 RMP (SR) 11 Other (specify)									
9 ABS 12 None used (open hole)									
SCREEN OR PERFORATION OPENINGS ARE:									
1 Continuous slot 3 Mill slot 5 Gauzed wrapped 8 Saw cut 11 None (open hole)									
2 Louvered shutter 4 Key punched 6 Wire wrapped 9 Drilled holes									
7 Torch cut 10 Other (specify) ft.									
SCREEN-PERFORATED INTERVALS: From 74.5 ft. to 96.5 ft., From ft. to ft.									
From ft. to ft., From ft. to ft.									
GRAVEL PACK INTERVALS: From 69 ft. to 100 ft., From ft. to ft.									
From ft. to ft., From ft. to ft.									
6 GROUT MATERIAL: 1 Neat cement 2 Cement grout 3 Bentonite 4 Other 50% Bentonite Holeplug									
Grout Intervals: From 67-69 ft. to 0-21 ft., From 65-67 ft. to 50% Sand 21 ft. to 65 ft.									
What is the nearest source of possible contamination:									
1 Septic tank 4 Lateral lines 7 Pit privy 10 Livestock pens 14 Abandoned water well									
2 Sewer lines 5 Cess pool 8 Sewage lagoon 11 Fuel storage 15 Oil well/Gas well									
3 Watertight sewer lines 6 Seepage pit 9 Feedyard 12 Fertilizer storage 16 Other (specify below)									
13 Insecticide storage None known									
Direction from well? How many feet?									
FROM TO LITHOLOGIC LOG FROM TO PLUGGING INTERVALS									
0 3 Topsoil									
3 35 Clay, brown									
35 64 Sand and gravel, fine, medium									
64 66 Clay, tan									
66 96 Sand and gravel, fine, medium									
96 100 Shale, black									
7 CONTRACTOR'S OR LANDOWNER'S CERTIFICATION: This water well was (1) constructed, (2) reconstructed, or (3) plugged under my jurisdiction and was completed on (mo/day/year) 1-5-01 and this record is true to the best of my knowledge and belief. Kansas Water Well Contractor's Licence No. 185 This Water Well Record was completed on (mo/day/yr) 1-15-01 under the business name of Clarke Well & Equipment, Inc. by (signature)									
INSTRUCTIONS: Use typewriter or ball point pen. PLEASE PRESS FIRMLY and PRINT clearly. Please fill in blanks, underline or circle the correct answers. Send top three copies to Kansas Department of Health and Environment, Bureau of Water, Topeka, Kansas 66620-0001. Telephone 785-296-5524. Send one to WATER WELL OWNER and retain one for your records. Fee of \$5.00 for each constructed well.									