227 5888 WATER WELL RECORD Form WWC-5 KSA 82a-1212 ID No. Well #2

1 LOCATION OF WATER WELL: County: Sedgwick | Fraction: NE 1/4 SE 1/4 SE 1/4 | Section Number: 36 | Township Number: T 26 S | Range Number: R 2 E (W)

Distance and direction from nearest town or city street address of well if located within city?
Approximately 1 mile west and 1 3/4 miles south of Maize

2 WATER WELL OWNER: RR#, St. Address, Box # : City of Maize, 123 Khedive, P.O. Box 245
City, State, ZIP Code : Maize, KS 67101

Board of Agriculture, Division of Water Resources
Application Number: 43,913

3 LOCATE WELL'S LOCATION WITH AN "X" IN SECTION BOX:

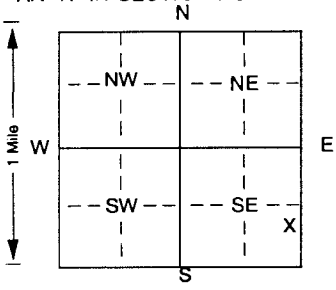

4 DEPTH OF COMPLETED WELL 194.52 ft. ELEVATION: unknown

Depth(s) Groundwater Encountered 1 ft. 2 ft. 3 . ft.

WELL'S STATIC WATER LEVEL 30 ft. below land surface measured on mo/day/yr 6-28-02

Pump test data: Well water was not checked ft. after hours pumping gpm

Est. Yield unknown gpm: Well water was ft. after hours pumping gpm

Bore Hole Diameter 38 in. to 194 ft., and in. to ft.

WELL WATER TO BE USED AS: (5) Public water supply 8 Air conditioning 11 Injection well
1 Domestic 3 Feedlot 6 Oil field water supply 9 Dewatering 12 Other (specify below)
2 Irrigation 4 Industrial 7 Domestic (lawn & garden) 10 Monitoring well

Was a chemical/bacteriological sample submitted to Department? Yes No ✓ If yes, mo/day/yrs sample was submitted
Water Well Disinfected? Yes ✓ No

5 TYPE OF BLANK CASING USED: (1) Steel 2 PVC 3 RMP (SR) 4 ABS 5 Wrought iron 6 Asbestos-Cement 7 Fiberglass 8 Concrete tile 9 Other (specify below)

CASING JOINTS: Glued Clamped Welded ✓ Threaded

Blank casing diameter 12 in. to 103.5 ft., Dia 12 in. to 122.8 ft., Dia 12 in. to 167.4 ft

Casing height above land surface 18 in., weight 49.56 lbs./ft. Wall thickness or gauge No .375

TYPE OF SCREEN OR PERFORATION MATERIAL:
1 Steel (3) Stainless steel 5 Fiberglass 7 PVC 10 Asbestos-cement
2 Brass 4 Galvanized steel 6 Concrete tile 8 RMP (SR) 11 Other (specify)
9 ABS 12 None used (open hole)

SCREEN OR PERFORATION OPENINGS ARE:
(1) Continuous slot 3 Mill slot 5 Gauzed wrapped 8 Saw cut 11 None (open hole)
2 Louvered shutter 4 Key punched 6 Wire wrapped 9 Drilled holes
7 Torch cut 10 Other (specify) ft.

SCREEN-PERFORATED INTERVALS: From 103.5 ft. to 113.8 ft., From 122.8 ft. to 148.4 ft.
From 167.4 ft. to 193.0 ft., From ft. to ft.

GRAVEL PACK INTERVALS: From 97 ft. to 194 ft., From ft. to ft.
From ft. to ft., From ft. to ft.

6 GROUT MATERIAL: 1 Neat cement (2) Cement grout 3 Bentonite 4 Other Benotnite Holeplug

Grout Intervals: From 0 ft. to 23 ft., From 23 ft. to 77 ft., From 77 ft. to 97 ft.
Road Sand

What is the nearest source of possible contamination:
1 Septic tank 4 Lateral lines 7 Pit privy 10 Livestock pens 14 Abandoned water well
2 Sewer lines 5 Cess pool 8 Sewage lagoon 11 Fuel storage 15 Oil well/Gas well
3 Watertight sewer lines 6 Seepage pit 9 Feedyard 12 Fertilizer storage 16 Other (specify below)
13 Insecticide storage None known

Direction from well? How many feet?

FROM	TO	LITHOLOGIC LOG	FROM	TO	PLUGGING INTERVALS
0	2	Topsoil	153.5	157	Clay, brown and gray
2	18	Clay, brown	157	160	Clay, brown
18	23	Clay, tan, sandy	160	164	Sand and gravel
23	74	Sand and gravel, fine and medium, some coarse,	164	164.5	Clay, sandy
		few clay streaks	164.5	165	Clay, gray
74	77	Clay, yellow	165	189	Sand and gravel, fine, medium, some coarse
77	84	Clay, gray	189	191	Clay with sand and gravel
84	88	Sand, medium	191	192	Sand and gravel, medium and coarse
88	100	Clay, gray	192	194	Cemented sand, hard
100	115	Sand and gravel, fine and medium			
115	124	Clay, gray and green			
124	148	Sand and gravel, fine, medium			
148	149	Clay, brown			
149	153.5	Clay, gray			

7 CONTRACTOR'S OR LANDOWNER'S CERTIFICATION: This water well was (1) constructed, (2) reconstructed, or (3) plugged under my jurisdiction and was completed on (mo/day/year) 6-28-02 and this record is true to the best of my knowledge and belief. Kansas Water Well Contractor's License No 185 This Water Well Record was completed on (mo/day/yr) 7-2-02
under the business name of Clarke Well & Equipment, Inc. by (signature)

INSTRUCTIONS: Use typewriter or ball point pen. *PLEASE PRESS FIRMLY* and *PRINT* clearly. Please fill in blanks, underline or circle the correct answers. Send top three copies to Kansas Department of Health and Environment, Bureau of Water, Topeka, Kansas 66620-0001. Telephone 785-296-5524. Send one to WATER WELL OWNER and retain one for your records. Fee of $5.00 for each constructed well.