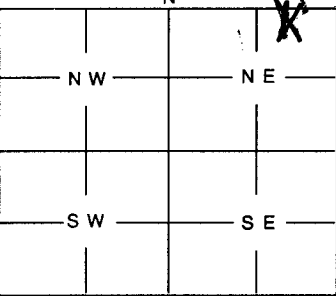


1	LOCATION OF WATER WELL: Sedgwick	Fraction 1/4 1/4 1/4	Section Number 21	Township Number 26 S	Range Number 2 W
---	--	--------------------------------	-----------------------------	--------------------------------	----------------------------

Distance and direction from nearest town or city street address of well if located within city? **329 W. Chicago - Colwich**

2	WATER WELL OWNER: JP Weigand RR #, St. Address, Box #: _____ City, State, ZIP Code : _____ Board of Agriculture, Division of Water Resources Application Number: _____
---	---

3	MARK WELL'S LOCATION WITH AN "X" IN SECTION BOX: <table border="1" style="margin: auto;"> <tr><td colspan="2">N</td></tr> <tr><td>W</td><td>E</td></tr> <tr><td>SW</td><td>SE</td></tr> <tr><td colspan="2">S</td></tr> </table> 	N		W	E	SW	SE	S					
N													
W	E												
SW	SE												
S													
4	DEPTH OF WELL 55 ft. WELL'S STATIC WATER LEVEL 25 ft. WELL WAS USED AS: <table style="width:100%;"> <tr> <td>1 Domestic</td> <td>5 Public Water Supply</td> <td>9 Dewatering</td> </tr> <tr> <td>2 Irrigation</td> <td>6 Oil Field Water Supply</td> <td>10 Monitoring Well</td> </tr> <tr> <td>3 Feedlot</td> <td>7 Domestic (Lawn & Garden)</td> <td>11 Injection Well</td> </tr> <tr> <td>4 Industrial</td> <td>8 Air Conditioning</td> <td>12 Other</td> </tr> </table> Was a chemical / bacteriological sample submitted to Department? Yes _____ No X If yes, mo/day/yr sample was submitted _____ Water Well Disinfected: Yes X No _____	1 Domestic	5 Public Water Supply	9 Dewatering	2 Irrigation	6 Oil Field Water Supply	10 Monitoring Well	3 Feedlot	7 Domestic (Lawn & Garden)	11 Injection Well	4 Industrial	8 Air Conditioning	12 Other
1 Domestic	5 Public Water Supply	9 Dewatering											
2 Irrigation	6 Oil Field Water Supply	10 Monitoring Well											
3 Feedlot	7 Domestic (Lawn & Garden)	11 Injection Well											
4 Industrial	8 Air Conditioning	12 Other											

5	TYPE OF BLANK CASING USED: <table style="width:100%;"> <tr> <td>1 Steel</td> <td>3 RMP (SR)</td> <td>5 Wrought</td> <td>7 Fiberglass</td> <td>9 Other (Specify below)</td> </tr> <tr> <td>2 PVC</td> <td>4 ABS</td> <td>6 Asbestos-Cement</td> <td>8 Concrete Tile</td> <td></td> </tr> </table> Blank casing diameter 5 in. Was casing pulled? Yes X No _____ If yes, how much _____ Casing height above or below land surface 30 in.	1 Steel	3 RMP (SR)	5 Wrought	7 Fiberglass	9 Other (Specify below)	2 PVC	4 ABS	6 Asbestos-Cement	8 Concrete Tile	
1 Steel	3 RMP (SR)	5 Wrought	7 Fiberglass	9 Other (Specify below)							
2 PVC	4 ABS	6 Asbestos-Cement	8 Concrete Tile								

6	GROUT PLUG MATERIAL: 1 Neat cement 2 Cement grout 3 Bentonite 4 Other _____ Grout Plug Intervals: From _____ ft. to _____ ft., From _____ ft. to _____ ft., From _____ ft. to _____ ft. What is the nearest source of possible contamination: <table style="width:100%;"> <tr> <td>1 Septic tank</td> <td>6 Seepage pit</td> <td>11 Fuel storage</td> <td>16 Other (specify below)</td> </tr> <tr> <td>2 Sewer lines</td> <td>7 Pit privy</td> <td>12 Fertilizer storage</td> <td></td> </tr> <tr> <td>3 Watertight sewer lines</td> <td>8 Sewage lagoon</td> <td>13 Insecticide storage</td> <td></td> </tr> <tr> <td>4 Lateral lines</td> <td>9 Feedyard</td> <td>14 Abandoned water well</td> <td></td> </tr> <tr> <td>5 Cess Pool</td> <td>10 Livestock pens</td> <td>15 Oil well/Gas well</td> <td></td> </tr> </table> Direction from well? East How many feet? 30	1 Septic tank	6 Seepage pit	11 Fuel storage	16 Other (specify below)	2 Sewer lines	7 Pit privy	12 Fertilizer storage		3 Watertight sewer lines	8 Sewage lagoon	13 Insecticide storage		4 Lateral lines	9 Feedyard	14 Abandoned water well		5 Cess Pool	10 Livestock pens	15 Oil well/Gas well	
1 Septic tank	6 Seepage pit	11 Fuel storage	16 Other (specify below)																		
2 Sewer lines	7 Pit privy	12 Fertilizer storage																			
3 Watertight sewer lines	8 Sewage lagoon	13 Insecticide storage																			
4 Lateral lines	9 Feedyard	14 Abandoned water well																			
5 Cess Pool	10 Livestock pens	15 Oil well/Gas well																			

FROM	TO	PLUGGING MATERIALS
55	25	gravel
25	3	cement
30		top soil

7	CONTRACTOR'S OR LANDOWNER'S CERTIFICATION: This water well was plugged under my jurisdiction and was completed on (mo/day/year) 5-4-03 and this record is true to the best of my knowledge and belief. Kansas Water Well Contractor's License No. 318 This Water Well Record was completed on (mo/day/year) _____ under the business name of Weninger Drilling & Inc. by (signature) Weninger
---	---

INSTRUCTIONS: Use typewriter or ball point pen. Please press firmly and print clearly. Please fill in blanks, underline or circle the correct answers. Send top three copies to Kansas Department of Health and Environment, Bureau of Water, Topeka, Kansas 66620-0001. Telephone: 785/296-3565. Send one to Water Well Owner and retain one for your records.