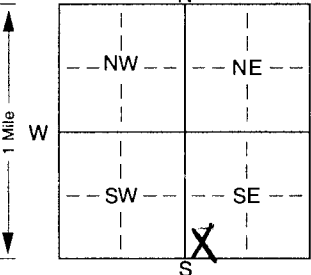


1 LOCATION OF WATER WELL: Fraction <u>SW 8th</u> Section Number <u>12</u> Township Number <u>20S</u> Range Number <u>20E</u>	
County: <u>Sedgwick</u> Distance and direction from nearest town or city street address of well if located within city? <u>see below</u>	
2 WATER WELL OWNER: <u>Ferry Drilling</u> RR#, St. Address, Box # <u>12480 W. 61st</u> City, State, ZIP Code <u>Maize, KS 67401</u> Board of Agriculture, Division of Water Resources Application Number: <u>36</u>	
3 LOCATE WELL'S LOCATION WITH AN "X" IN SECTION BOX: 	4 DEPTH OF COMPLETED WELL: <u>36</u> ft. ELEVATION: <u>7-14-03</u> ft. Depth(s) Groundwater Encountered 1. <u>10</u> ft. 2. <u>11</u> ft. 3. <u>11</u> ft. submitted to Department? Yes <u>X</u> No <u>X</u> ; If yes, mo/day/yr sample was submitted Water Well Disinfected? Yes <u>X</u> No <u>X</u>
5 TYPE OF BLANK CASING USED: 1 Steel 3 RMP (SR) 5 Wrought iron 8 Concrete tile CASING JOINTS: Glued <u>X</u> Clamped <u>X</u> 2 PVC 4 ABS 6 Asbestos-Cement 9 Other (specify below) Welded <u>X</u> Blank casing diameter <u>5</u> in. PERFORATION OPENINGS ARE: 1 Continuous slot 3 Mill slot 5 Gauzed wrapped 8 Saw cut 11 None (open hole) 2 Louvered shutter 4 Key punched 7 Torch cut 9 Drilled holes 12 None used (open hole) SCREEN-PERFORATED INTERVALS: From <u>26</u> ft. 
6 GROUT MATERIAL: 1 Neat cement 2 Cement grout 3 Bentonite 4 Other <u>150</u> Grout Intervals: From <u>3</u> ft. to <u>10</u> ft., What is the nearest source of possible contamination: 1 Septic tank 4 Lateral lines 7 Pit privy 10 Livestock pens 14 Abandoned water well 2 Sewer lines 5 Cess pool 8 Sewage lagoon 11 Fuel storage 15 Oil well/Gas well 3 Watertight sewer lines 6 Seepage pit 9 Feedyard 12 Fertilizer storage 16 Other (specify below) Direction from well? <u>west</u> How many feet? <u>150</u>	
FROM TO LITHOLOGIC LOG	FROM TO PLUGGING INTERVALS
0 2 top soil	
2 35 fine to med sand	
35 36 shale	
7 CONTRACTOR'S OR LANDOWNER'S CERTIFICATION: This water well was (1) constructed, (2) reconstructed, or (3) plugged under my jurisdiction and was completed on (mo/day/year) <u>7-14-03</u> and this record is true to the best of my knowledge and belief. Kansas Water Well Contractor's Licence No. <u>318</u> This Water Well Record was completed on (mo/day/yr) <u>7-16-03</u> under the business name of <u>Wenger Drilling Inc.</u> by (signature) <u>Michael Wenger</u>	
INSTRUCTIONS: Use typewriter or ball point pen. PLEASE PRESS FIRMLY and PRINT clearly. Please fill in blanks, underline or circle the correct answers. Send top three copies to Kansas Department of Health and Environment, Bureau of Water, Topeka, Kansas 66620-0001. Telephone 785-296-5524. Send one to WATER WELL OWNER and retain one for your records. Fee of \$5.00 for each constructed well.	