GSI No. 037243 **West Well (Inside bldg.)**

WATER WELL PLUGGING RECORD Form WWC-5P KSA 82a-1212 ID No. _____

1 LOCATION OF WATER WELL:	Fraction	Section Number	Township Number	Range Number
County: **Sedgwick**	**SW ¼ NE ¼ SE ¼**	**13**	**26**	**02 W**

Distance and direction from nearest town or city street address of well if located within city?
5605 N. 119th St. West (Coleman Beacon Plant)

2 WATER WELL OWNER: **The Coleman Company**
RR#, St. Address, Box # **5605 North 119th Street West** Board of Agriculture, Division of Water Resources
City, State, ZIP Code : **Maize, KS 67101** Application Number:

3 MARK WELL'S LOCATON WITH AN "X" IN SECTION BOX:

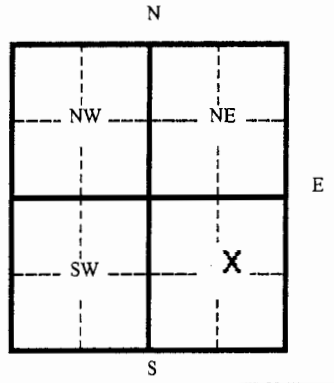

4 DEPTH OF WELL **61.4** ft.

WELL'S STATIC WATER LEVEL **16.0** ft.

WELL WAS USED AS:

1 Domestic 5 Public Water Supply 9 Dewatering
2 Irrigation 6 Oil Field Water Supply 10 Monitoring Well
3 Feedlot 7 Lawn and Garden (domestic) 11 Injection Well
(4 Industrial) 8 Air Conditioning 12 Other _____

Was a chemical/bacteriological sample submitted to Department? Yes ___ No X
If yes, mo/day/yr sample was submitted _____
Water Well Disinfected: Yes ___ No X

5 TYPE OF BLANK CASING USED:

1 Steel 3 RMP (SR) 5 Wrought 7 Fiberglass 9 Other (specify below)
2 PVC 4 ABC 6 Asbestos-Cement 8 Concrete Tile

Blank casing diameter **5** in. Was casing pulled? Yes ___ No X If yes, how much _____

Casing height above or below land surface **12** in. **Chiseled down 1 ft below the surface**

6 GROUT PLUG MATERIAL: 1 Neat cement 2 Cement grout (3 Bentonite) (4 Other **Concrete**)

Grout Plug Intervals From **0** ft. to **3** ft. From **3** ft. to **61.4** ft. From _____ ft. to _____ ft.

What is the nearest source of possible contamination:

1 Septic tank 6 Seepage pit 11 Fuel storage 16 Other (specify below)
2 Sewer lines 7 Pit privy 12 Fertilizer storage
3 Watertight sewer lines 8 Sewage lagoon 13 Insecticide storage
4 Lateral lines 9 Feedyard 14 Abandoned water well
5 Cess Pool 10 Livestock pens 15 Oil well/ Gas well

Direction from well? _____ How many feet? _____

FROM	TO	CODE	PLUGGING MATERIALS
0	3		**Concrete**
3	61.4		**Bentonite 500 lbs**

Well could not be over drilled due the location. The well was between a wall and guard railing. Electrical equipment was next to the well on the wall.

7 CONTRACTOR'S OR LANDOWNER'S CERTIFICATION: This water well was plugged under my jurisdiction and was completed on (mo/day/yr) **9-17-03** and this record is true to the best of my knowledge and belief. Kansas Water Well Contractor's License No. **531** This Water Well Record was completed on (mo/day/yr) **9-30-03** under the business name of **Geotechnical Services, Inc.**

by (signature) _____

INSTRUCTIONS: Please fill in blanks and circle the correct answers. Send three copies to Kansas Department of Health and Environment, Bureau of Water, 1000 S W Jackson St., Ste. 420, Topeka, Kansas 66620-0001. Telephone: 785-296-3565. Send one to Water Well Owner and retain one for your records.