

|         |                         |                      |                |                 |              |
|---------|-------------------------|----------------------|----------------|-----------------|--------------|
| 1       | LOCATION OF WATER WELL: | Fraction             | Section Number | Township Number | Range Number |
| County: | Sedgwick                | NW 1/4 SW 1/4 SW 1/4 | 13             | T 26 S          | R 2 E        |

Distance and direction from nearest town or city street address of well if located within city?

135<sup>th</sup> W & S3 rd N. 1/4 North on East side of 135<sup>th</sup>

|   |                   |
|---|-------------------|
| 2 | WATER WELL OWNER: |
|---|-------------------|

RR#, St. Address, Box # :  
City, State, ZIP Code :


DICK GORDES

Board of Agriculture, Division of Water Resources  
Application Number:

3 LOCATE WELL'S LOCATION WITH

4 DEPTH OF COMPLETED WELL ..... 30 ..... ft. ELEVATION:

AN "X" IN SECTION BOX:

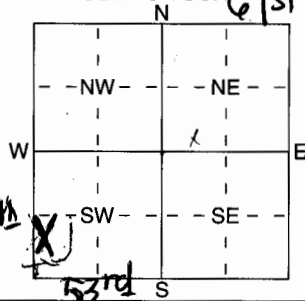

Depth(s) Groundwater Encountered 1 ..... ft. 2 ..... ft. 3 ..... ft.  
WELL'S STATIC WATER LEVEL 12 ..... ft. below land surface measured on mo/day/yr 8-31-04  
Pump test data: Well water was ..... ft. after ..... hours pumping ..... gpm  
Est. Yield ..... gpm: Well water was ..... ft. after ..... hours pumping ..... gpm  
WELL WATER TO BE USED AS: 5 Public water supply 8 Air conditioning 11 Injection well  
Domestic 3 Feedlot 6 Oil field water supply 9 Dewatering 12 Other (Specify below)  
2 Irrigation 4 Industrial 7 Domestic (lawn & garden) 10 Monitoring well .....

Was a chemical/bacteriological sample submitted to Department? Yes ..... No ..... X .....; If yes, mo/day/hrs sample was submitted  
Water Well Disinfected? (yes) (yes) No

|   |                            |
|---|----------------------------|
| 5 | TYPE OF BLANK CASING USED: |
|---|----------------------------|

|                   |                         |
|-------------------|-------------------------|
| 5 Wrought iron    | 8 Concrete tile         |
| 6 Asbestos-Cement | 9 Other (specify below) |
| 7 Fiberglass      | .....                   |

CASING JOINTS: Glued ..... Clamped .....  
Welded .....  
Threaded .....

Blank casing diameter 3 in. to 40 ft. Dia 3 in. to 40 ft. Dia 3 in. to 40 ft.  
Casing height above land surface 12 in. weight 2.40 lbs./ft. Wall thickness or guage No. 160 psi

TYPE OF SCREEN OR PERFORATION MATERIAL:

5 Fiberglass  
6 Concrete tile  
7 PVC  
8 RMP (SR)  
9 ABS  
10 Asbestos-Cement  
11 Other (Specify) .....  
12 None used (open hole)

SCREEN OR PERFORATION OPENINGS ARE:

5 Guazed wrapped                      8 Saw cut                      11 None (open hole)  
6 Wire wrapped                      9 Drilled holes  
7 Torch cut                      10 Other (specify) .....

SCREEN-PERFORATED INTERVALS: From 40 ft. to 30 ft. From \_\_\_\_\_ ft. to \_\_\_\_\_ ft.  
From \_\_\_\_\_ ft. to \_\_\_\_\_ ft. From \_\_\_\_\_ ft. to \_\_\_\_\_ ft.

GRAVEL PACK INTERVALS: From 12 ft. to 30 ft. From \_\_\_\_\_ ft. to \_\_\_\_\_ ft.  
From \_\_\_\_\_ ft. to \_\_\_\_\_ ft. From \_\_\_\_\_ ft. to \_\_\_\_\_ ft.

|   |                 |
|---|-----------------|
| 6 | GROUT MATERIAL: |
|---|-----------------|

1 Neat cement . 2 Cement grout

3 Bentonite 4 Other.....

Grout Intervals: From 3 ft. to 12 ft. From \_\_\_\_\_ ft. to \_\_\_\_\_ ft. From \_\_\_\_\_ ft. to \_\_\_\_\_ ft.

What is the nearest source of possible contamination:

|                 |                        |                          |
|-----------------|------------------------|--------------------------|
| 7 Pit privy     | 10 Livestock pens      | 14 Abandoned water well  |
| 8 Sewage lagoon | 11 Fuel storage        | 15 Oil well/Gas well     |
| 9 Feedyard      | 12 Fertilizer storage  | 16 Other (specify below) |
|                 | 13 Insecticide storage | .....                    |

Direction from well?

Fast

How many feet? 1100 ft

[illegible]

7 CONTRACTOR'S OR LANDOWNER'S CERTIFICATION: This water well was (1) constructed, (2) reconstructed, or (3) plugged under my jurisdiction and was

completed on (mo/day/year) 8-31-04 and this record is true to the best of my knowledge and belief. Kansas  
Water Well Contractor's Licence No 318 This Water Well Record was completed on (mo/day/yr) 9-1-04  
under the business name of Weninger Drilling Inc by (signature) [Signature]